LAND CORNER RECORDATION CERTIFICATE

Filing Requirement of Act 74, Mich. P.A. 1970

For corners in
OTSEGO
(County)

	Located In:	Corner Code ##
1. Public Land Survey	T 29N R 4W	E-11
	T ___ R ___	
	T ___ R ___	
	T ___ R ___	
2. Property Controlling	S 32 T ___ R ___	1
in Section	S 32 T ___ R ___	2
3. Miscellaneous	S ___ T ___ R ___	
Property in Sec.	S ___ T ___ R ___	

Register of Deeds Stamp & File Number

4. Lot No. ___, Recorded Plat ___
5. Private Claims ___

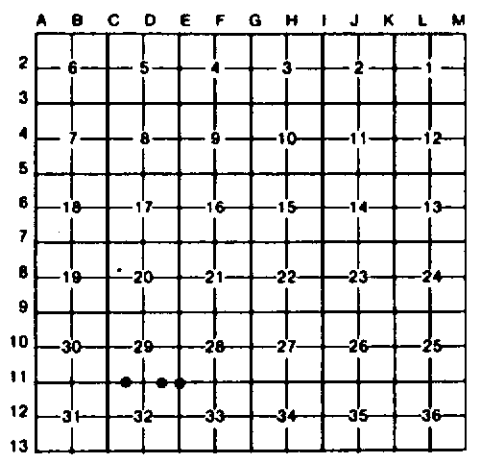

I, Carl R. Johnson, in a field survey on March 31, 19 92, do hereby certify that under requirements of P.A. 74, Michigan P.A. of 1970, the corner points mentioned in lines 1 and 2 above were in conformance with regulations and rules therefore as required in the current manual of survey instructions of the United States Department of the Interior, Bureau of Land Management or by a decree of a Court of Law and/or that the corner points mentioned in lines 3, 4 and 5 above were in conformance with the rules of the Michigan Board of Land Surveyors or by a Decree of a Court of Law; established, re-established, monumented, re-monumented, recovered, found as expressed below:

NOTE: Not more than 4 corners, all in the same town and range, may be recorded on this certificate.

A. Description of original monument and accessories and/or subsequent restoration:

E-11	1	2

B. Description of corner evidence found and/or method applied in restoring or reestablishing corner:

E-11	1	2
Found monument in place as used and accepted in other surveys.	Set by standard survey procedure for subdivision of a section.	Set by standard survey procedure for subdivision of a section.

C. Description of monument for corner and accessories established to perpetuate locating the position of the corner:

E-11	1	2
NE Cor Sec.32	W1/8 cor. on N.line sec. 32	E1/8 cor. on N.line sec. 32
Fd. 1/2" Bar in Concrete	1/2" bar w/cap	1/2" bar w/cap
Maple 10" N80E 15.0 ft	Maple 6" S60E 25.43 ft	Maple 4" S42E 13.65 ft
Ironwood 5" S15W 8.1 ft	Maple 12" S31W 50.37 ft	Maple 6" S34W 44.37 ft
Maple 8" N29W 54.1 ft	Maple 6" S53W 43.47 ft	Beech 10" N08W 36.35 ft
	Ironwood 5" N04E 63.75 ft	Beech 6" S89E 24.88 ft

STATE OF MICHIGAN
CARL R. JOHNSON
LAND SURVEYOR
No. 30083
LICENSED LAND SURVEYOR

Signed by [signature] Date 7/7/92

Surveyor's Michigan License No. 30083

FORM APPROVED BY MICHIGAN STATE BOARD OF LAND SURVEYORS, JAN. 28, 1971
REVISED MAY 14, 1975
REVISED JAN., 1983