

# SURVEY & REMONUMENTATION

APR 25 1995

**COMMISSION**  
OTSEGO  
(County)

OTSEGO COUNTY REMONUMENTATION  
**LAND CORNER RECORDATION CERTIFICATE**  
Filing Requirement of Act 74, Mich. P.A. 1970  
ALSO ACT 345, PA 1990

LIBER 004 PAGE 039

OTSEGO COUNTY  
MICHIGAN  
RECEIVED FOR RECORD  
94 DEC 29 PM 1:30  
LYLE H. PRATT  
CLERK / REGISTER OF DEEDS

	Located in:	Corner Code #
1. Public Land Survey	T 29N R 4W	C-9
	T _____ R _____	_____
	T _____ R _____	_____
2. Property Controlling in Section	S _____ T _____ R _____	_____
	S _____ T _____ R _____	_____
3. Miscellaneous Property in Sec.	S _____ T _____ R _____	_____
	S _____ T _____ R _____	_____
4. Lot No. _____, Recorded Plat _____		
5. Private Claims _____		

Register of Deeds Stamp & File Number

	A	B	C	D	E	F	G	H	I	J	K	L
2	6	5	4	3	2							
3												
4	7	8	9	10	11	12						
5												
6	13	17	16	15	14	13						
7												
8	19	20	21	22	23	24						
9												
10	30	29	28	27	26	25						
11												
12	31	32	33	34	35	36						
13												

I, James L. Schwandt, in a field survey on December 5, 1994, do hereby certify that under requirements of P.A. 74, Michigan P.A. of 1970, the corner points mentioned in lines 1 and 2 above were in conformance with regulations and rules therefore as required in the current manual of survey instructions of the United States Department of the Interior, Bureau of Land Management or by a decree of a Court of Law and/or that the corner points mentioned in lines 3, 4 and 5 above were in conformance with the rules of the Michigan Board of Land Surveyors or by a Decree of a Court of Law, established, re-established, monumented, re-monumented, recovered, found as expressed below:

**NOTE: Not more than 4 corners, all in the same town and range, may be recorded on this certificate.**

**A. Description of original monument and accessories and/or subsequent restoration:**


- |   |  |   |
|---|--|---|
| G.L.O. Harvey Mollen, 1856<br>Set Post<br>18" W. Pine N61°W 18 Lks.<br>9" Maple N57°E 23 Lks. | Delamater, year unknown<br>Fd. 1/2" iron and one B & P<br>Y. Pine 14", S66E, 55.2'<br>Y. Pine 12", South, 145.9' | Stanley Thorson #5788, 1958<br>1/2" x 24" iron submitted by<br>T. F. Schweigart for recording<br>Set Post N45°E 33.0'<br>Set Post S45°E 33.0'   |
|   |  | Carl I. Robinson, 1980<br>Fd. 1/2" bar in corner<br>Fd. Spk. in 18" Y. Pine S66°E 55.11'<br>Fd. Spk. in 16" Y. Pine South 145.88'<br>Fd. RLS Tag in metal post S40°E 32.98'<br>Fd. RLS Tag in metal post N50°E 33.00'<br>Replaced corner w/O.C.M.<br>Set Spk. 6" R. Pine N15°E 33.43'<br>Set Spk. 6" R. Pine S85°W 17.62' |

**B. Description of corner evidence found and/or method applied in restoring or reestablishing corner:**

Found O.C.M. set by C. I Robinson per L.C.R.C. L2, P. 168 replacing 1/2" iron fd. by T.F. Schweigert for S. Thorson 1958. Found Robinson's R. Pines, Schweigert's metal posts and Delamater's Y. Pines. Delamater's position based on one B & P per C.S.R.

**C. Description of monument for corner and accessories established to perpetuate locating the position of the corner:**

- C-9 Found O.C.M. is accepted as a careful and faithful perpetuation of the position of the original corner.
- 12" R. Pine N15°E 33.43' Found Spike
  - 20" Y. Pine S66°E 55.11' Found Spike
  - St. Post S40°E 32.98' Found Street Post w/Tag
  - 14" R. Pine S85°W Found Spike

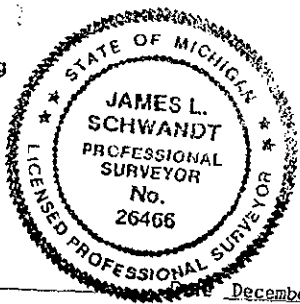

OTSEGO COUNTY REMONUMENTATION  
Approved by the County Survey Peer  
Group, pursuant to Act 345, PA 1990.  
Dec 7, 1994 \_\_\_\_\_  
Date Chairman

Signed by James L. Schwandt  
James L. Schwandt, PS  
Surveyor's Michigan License No. 26466

December 7, 1994