

LAND CORNER RECORDATION CERTIFICATE

Filing Requirement of Act 74, Mich. PA 1970

For Corners In:
 Otsego _____ Located In _____ Corner Code # _____
 (County)

1. Public Land Survey	S	T	_____	R	_____	_____
		T	_____	R	_____	_____
2. Property Controlling in Section	S	25	T	29N	R	4W
	S	25	T	29N	R	4W
						7
						5
3. Miscellaneous Property in Section	S	_____	T	_____	R	_____
	S	_____	T	_____	R	_____


4. Lot No: _____ Recorded Plat: _____

5. Private Claims: _____

I, Carl T. Kiiskila, in a field survey on September 30, 2002 do hereby state that under requirements of PA 74, Michigan PA of 1970, the corner points mentioned in lines 1 and 2 above were in conformance with regulations and rules therefore as required in the current manual of survey instructions of the United States Department of the Interior, Bureau of Land Management or by a decree of a Court of Law and/or that the corner points mentioned in lines 3, 4 and 5 above were in conformance with the rules of the Michigan Board of Land Surveyors or by a Decree of a Court of Law; established, re-established, monumented, recovered, found as expressed below:

NOTE: Not more than 2 corners, all in the same town and range, may be recorded on this certificate.

Register of Deeds Stamp & File Number

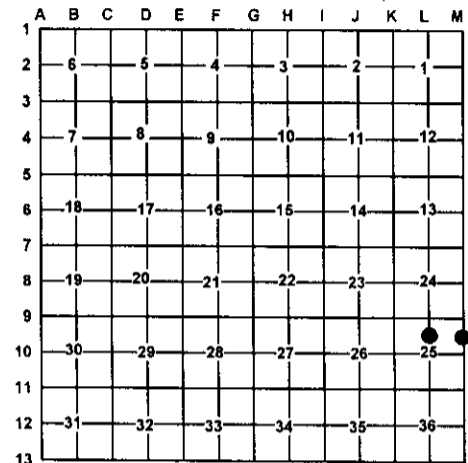

A. Description of original monument and accessories and/or subsequent restoration:

5- This corner position was not established during the original government survey.

7- This corner position was not established during the original government survey.

B. Description of corner evidence found and/or method applies in restoring or re-establishing corner:

5- Established the Northwest corner of the Southwest quarter of the Northeast quarter of section 25 as per B.L.M. instructions for the subdivision of a section.

7- Established the Southeast corner of the Northeast quarter of the Northeast quarter of section 25 as per B.L.M. instructions for the subdivision of a section.

C. Description of monument for corner and accessories established to perpetuate locating the position of the corner:

5- Set 5/8" X 32" rered with P.S. cap the #33981

Wit: 6" Maple	N85°E	21.22'
6" Maple	S42°E	19.12'
8" Maple	N16°W	20.08'
12" Oak	S60°W	29.54'
Carsonite Post North		1'±

7- Set 5/8" X 32" rered with P.S. cap #33981

Wit: 12" Beech	S66°E	13.58'
7" Maple	N21°E	7.05'
7" Beech	S80°W	9.86'
7" Maple	S12°E	35.35'
Carsonite Post North		1'±

Signed by: _____

Carl T. Kiiskila

Date: _____

1-8-03

Surveyor's Michigan License No.: _____

33981

