

OTSEGO COUNTY REMONUMENTATION  
**LAND CORNER RECORDATION CERTIFICATE**  
 Filing Requirement of Act 74, Mich. PA 1970

For Corners In: \_\_\_\_\_ Located In Hayes Twp Corner Code #  
 Otsego \_\_\_\_\_  
 (County)

1. Public Land Survey	T	29N	R	4W	K-9
	T	_____	R	_____	_____
2. Property Controlling in Section	S	T	R	_____	_____
	S	_____	R	_____	_____
3. Miscellaneous Property in Section	S	T	R	_____	_____
	S	_____	R	_____	_____


4. Lot No: \_\_\_\_\_ Recorded Plat: \_\_\_\_\_

5. Private Claims: \_\_\_\_\_

I, Carl T. Kiiskila, in a field survey on October 31, 2002 do hereby state that under requirements of PA 74, Michigan PA of 1970, the corner points mentioned in lines 1 and 2 above were in conformance with regulations and rules therefore as required in the current manual of survey instructions of the United States Department of the Interior, Bureau of Land Management or by a decree of a Court of Law and/or that the corner points mentioned in lines 3, 4 and 5 above were in conformance with the rules of the Michigan Board of Land Surveyors or by a Decree of a Court of Law; established, re-established, monumented, recovered, found as expressed below:

**NOTE: Not more than 2 corners, all in the same town and range, may be recorded on this certificate.**

Register of Deeds Stamp & File Number

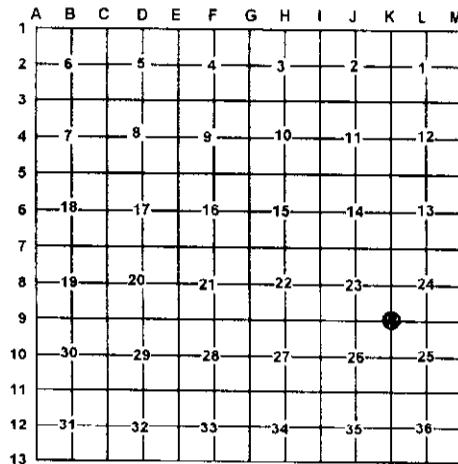

A. Description of original monument and accessories and/or subsequent restoration:

K-9 G.L.O. Harvey Mellen D.S. 1856  
 Set post at corner of sections 23,24,25 and 26  
 Wit: W. Pine 12" N71°E 10 links  
 Cedar 12" S45°W 21 links

Liber 1, Page 375, 1974 Gerald McKelvey R.L.S. #19001 set a concrete monument by proration from geographic features and section corner to North.

Wit: S45°W 13.62' 4" Maple  
 S10°W 17.52' 3" Cherry  
 N45°W 27.56' 4" Cherry

B. Description of corner evidence found and/or method applies in restoring or re-establishing corner:

K-9 Found a concrete monument as set by Gerald McKelvey.

C. Description of monument for corner and accessories established to perpetuate locating the position of the corner:

K-9 4" Concrete Monument with 1/2" iron bar is accepted as a careful and faithful re-establishment of the position of the original corner.

Wit: 10" Cherry S34°W 17.70'  
 10" Maple S80°W 13.59'  
 12" Oak N22°E 33.41'  
 4" Maple N41°E 37.10'  
 Edge of Lynn Lake West 24'±  
 Carsonite Post North 1'±



Signed by: \_\_\_\_\_

*Carl T. Kiiskila*

Date: \_\_\_\_\_

12-23-02

Surveyor's Michigan License No.: 33981