

OTSEGO COUNTY REMONUMENTATION
LAND CORNER RECORDATION CERTIFICATE
 Filing Requirement of Act 74, Mich. PA 1970

For Corners In:
 Otsego _____ Located In Hayes Twp. Corner Code #
 (County)

1. Public Land Survey	T	<u>29N</u>	R	<u>4W</u>	<u>K-10</u>
	T	_____	R	_____	_____
2. Property Controlling in Section	S	T	R		
	S	_____	R	_____	_____
3. Miscellaneous Property in Section	S	T	R		
	S	_____	R	_____	_____


4. Lot No: _____ Recorded Plat: _____

5. Private Claims: _____

Register of Deeds Stamp & File Number

I, Carl T. Kiiskila, in a field survey on October 31, 2002 do hereby state that under requirements of PA 74, Michigan PA of 1970, the corner points mentioned in lines 1 and 2 above were in conformance with regulations and rules therefore as required in the current manual of survey instructions of the United States Department of the Interior, Bureau of Land Management or by a decree of a Court of Law and/or that the corner points mentioned in lines 3, 4 and 5 above were in conformance with the rules of the Michigan Board of Land Surveyors or by a Decree of a Court of Law; established, re-established, monumented, recovered, found as expressed below:

NOTE: Not more than 2 corners, all in the same town and range, may be recorded on this certificate.

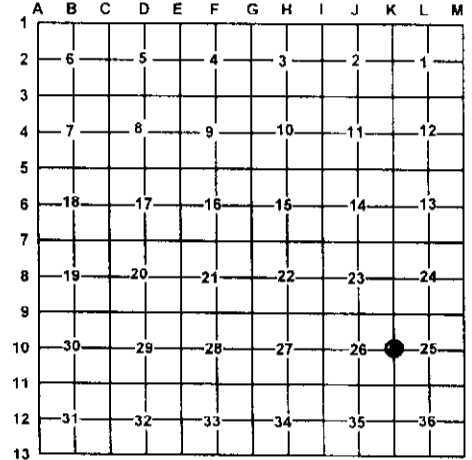

A. Description of original monument and accessories and/or subsequent restoration:

K-10 G.L.O. Harvey Mellen D.S. 1856
 Set quarter section post
 Wit: Y. Pine 12" N59°W 23 links (15.2')
 W. Pine 9" N76°E 18 links (11.9')

1974 Gerald McKelvey R.L.S. #19001 used this corner while working in sections 23,25 & 26.

B. Description of corner evidence found and/or method applies in restoring or re-establishing corner:

K-10 Found 1" Bar as used by Gerald McKelvey R.L.S. #19001 in 1974.

C. Description of monument for corner and accessories established to perpetuate locating the position of the corner:

K-10 Found 1" iron bar set Otsego County Monument is accepted as the best available evidence of the position of the original corner.

Wit: 5" W. Pine	S62°W	18.32'
14" R. Pine	N77°W	63.18'
6" R. Pine	N05°E	61.37'
10" W. Pine	N83°E	52.90'
*17" Pine stump	N30°E	5.96'
Possible G.L.O. B.T. Stump		
*19" Y. Pine stump	N57°W	15.79'

* Old witnesses by others

Signed by: Carl T. Kiiskila
 Surveyor's Michigan License No.: 33981

Date: 12-23-02

