

OTSEGO COUNTY REMONUMENTATION  
**LAND CORNER RECORDATION CERTIFICATE**  
 Filing Requirement of Act 74, Mich. PA 1970

For Corners In:  
Otsego Located In Hayes Twp. Corner Code #  
 (County)


1. Public Land Survey	T	<u>29N</u>	R	<u>4W</u>	<u>L-9</u>
	T	_____	R	_____	_____
2. Property Controlling in Section	S	T	R		
	S	T	R		
3. Miscellaneous Property in Section	S	T	R		
	S	T	R		

4. Lot No: \_\_\_\_\_ Recorded Plat: \_\_\_\_\_  
 5. Private Claims: \_\_\_\_\_

I, Carl T. Kiiskila, in a field survey on October 10, 2002 do hereby state that under requirements of PA 74, Michigan PA of 1970, the corner points mentioned in lines 1 and 2 above were in conformance with regulations and rules therefore as required in the current manual of survey instructions of the United States Department of the Interior, Bureau of Land Management or by a decree of a Court of Law and/or that the corner points mentioned in lines 3, 4 and 5 above were in conformance with the rules of the Michigan Board of Land Surveyors or by a Decree of a Court of Law; established, re-established, monumented, recovered, found as expressed below:

**NOTE: Not more than 2 corners, all in the same town and range, may be recorded on this certificate.**

Register of Deeds Stamp & File Number

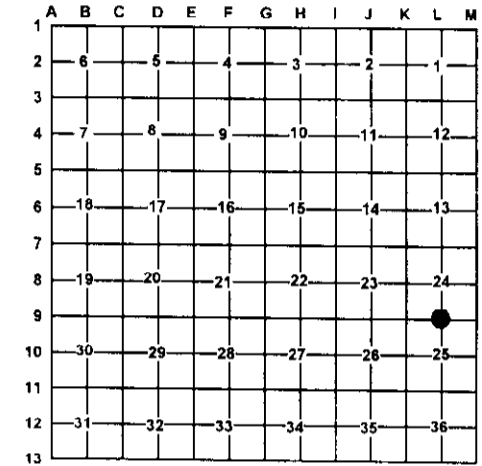

A. Description of original monument and accessories and/or subsequent restoration:

L-9 G.L.O. Harvey Mellen 1857  
 Set quarter section post  
 Wit: Beech 12 N28°E 35 links  
 Beech 12 N30°W 3 links

B. Description of corner evidence found and/or method applies in restoring or re-establishing corner:

L-9 Re-established the North quarter corner of section 25  
 midway and on line between corners K-9 and M-9.

C. Description of monument for corner and accessories established to perpetuate locating the position of the corner:

L-9 Set Otsego County Monument as a careful and faithful re-establishment of the position of the original corner.  
 Wit: 14" Beech S84°E 25.33'  
 5" Maple S01°W 23.09'  
 8" Triple Maple N87°W 19.29'  
 8" Maple N70°W 4.52'  
 Carsonite Post North 1±



Signed by: Carl T. Kiiskila  
 Surveyor's Michigan License No.: 33981

Date: 12-23-02