

LAND CORNER RECORDATION CERTIFICATE


Filing Requirement of Act 74, Mich. PA 1970

For Corners In: <u>Otsego</u> (County)	Located In	Corner Code #	
1. Public Land Survey	T <u>29N</u> R <u>4W</u>	<u>A-10</u>	
	T <u>29N</u> R <u>4W</u>	<u>A-11</u>	
2. Property Controlling in Section	S _____ T _____ R _____		
	S _____ T _____ R _____		
3. Miscellaneous Property in Section	S _____ T _____ R _____		
	S _____ T _____ R _____		
4. Lot No: _____	Recorded Plat: _____		
5. Private Claims: _____			

Register of Deeds Stamp & File Number

I, Carl T. Kiiskila, in a field survey on April 8, 2003 do hereby state that under requirements of PA 74, Michigan PA of 1970, the corner points mentioned in lines 1 and 2 above were in conformance with regulations and rules therefore as required in the current manual of survey instructions of the United States Department of the Interior, Bureau of Land Management or by a decree of a Court of Law and/or that the corner points mentioned in lines 3, 4 and 5 above were in conformance with the rules of the Michigan Board of Land Surveyors or by a Decree of a Court of Law; established, re-established, monumented, recovered, found as expressed below:

NOTE: Not more than 2 corners, all in the same town and range, may be recorded on this certificate.

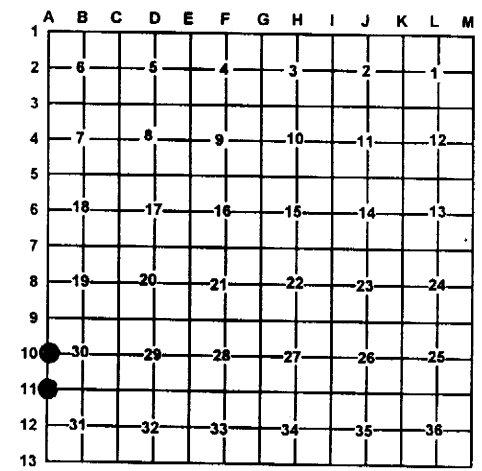

A. Description of original monument and accessories and/or subsequent restoration:

<p>A-10 G.L.O. 1839 James H. Mullett Set quarter section post Wit: Beech 12 N43°W 15 links Beech 18 S42°W 30 links</p> <p>May 1957, Michigan Department of Conservation Land Corner Records show they re-established the West quarter corner of section 25 by proportionate measurement, and set a Michigan Department of conservation monument. Wit: 36" W. Pine Stump N54°W 67 links 18" W. Pine Stump S22°W 112 links</p>	<p>A-11 G.L.O. 1839 James H. Mullett set section post Wit: Hemlock 12 N44°W 25 links Beech 16 S69°W 34 links</p> <p>May 1957, Michigan Department of Conservation Land Corner Records show they re-established the Southwest corner of section 30 by proportionate measurement and set a Michigan Department of Conservation monument. Wit: 8" Maple N58°E 128.5 links 7" Maple S78°W 48.25 links</p> <p>Paul B. Lapham Liber 3, Page 105, May 1993 Found DNR monument. Wit: 10" J. Pine N60°E 19.25' 10" J. Pine S65°E 20.5' 16" Twin R. Pine S15°W 22.94' 14" R. Pine S70°W 30.6'</p>
--	---

B. Description of corner evidence found and/or method applies in restoring or re-establishing corner:

<p>A-10 Found a Michigan Department of Conservation Monument fitting the Michigan Department of Conservation survey in section 30.</p>	<p>A-11 Found a Michigan Department of Conservation Monument pulled out and laying on ground. Re-established the Southwest corner of section 30 using two of the witnesses recorded in Liber 3, Page 105 by Paul B. Lapham</p>
--	--

C. Description of monument for corner and accessories established to perpetuate locating the position of the corner:

<p>A-10 Found a Michigan Department of Conservation Monument. Wit: 12" Twin R. Pine S59°W 36.15' 8" Twin R. Pine S28°W 46.31' 5" J. Pine N91°E 75.47' 7" Cherry N17°W 4.62'</p>	<p>A-11 Reset a Michigan Department of Conservation Monument. Wit: 5" J. Pine N48°E 26.81' 12" Twin R. Pine S28°W 22.95' 5" J. Pine S64°E 31.33' 12" R. Pine S66°W 30.56'</p>
---	---

Signed by: Carl T. Kiiskila
Surveyor's Michigan License No.: 33981

Date: 6-7-04

