

LAND CORNER RECORDATION CERTIFICATE

Filing Requirement of Act 74, Mich. P.A. 1970

For comers in Otsego (County) Located In: \_\_\_\_\_ Corner Code # \_\_\_\_\_

1. Public Land Survey T 30N R 3W \_\_\_\_\_ A-4  
 T \_\_\_\_\_ R \_\_\_\_\_  
 T \_\_\_\_\_ R \_\_\_\_\_  
 T \_\_\_\_\_ R \_\_\_\_\_

2. Property Controlling S \_\_\_\_\_ T \_\_\_\_\_ R \_\_\_\_\_  
 in Section S \_\_\_\_\_ T \_\_\_\_\_ R \_\_\_\_\_

3. Miscellaneous S \_\_\_\_\_ T \_\_\_\_\_ R \_\_\_\_\_  
 Property in Section S \_\_\_\_\_ T \_\_\_\_\_ R \_\_\_\_\_

4. Lot No. \_\_\_\_\_, Recorded Plat \_\_\_\_\_

5. Private Claims \_\_\_\_\_

OTSEGO COUNTY  
 MICHIGAN  
 RECEIVED FOR RECORD  
 95 DEC -6 PM 1:27  
 ELLIOTT M. PRATT  
 CLERK / REGISTER OF DEEDS

Register of Deeds Stamp & File Number

|    |    |    |    |    |    |    |   |   |   |   |   |   |
|----|----|----|----|----|----|----|---|---|---|---|---|---|
| A  | B  | C  | D  | E  | F  | G  | H | I | J | K | L | M |
| 2  | 6  | 5  | 4  | 3  | 2  |    |   |   |   |   |   |   |
| 3  |    |    |    |    |    |    |   |   |   |   |   |   |
| 4  | 7  | 8  | 9  | 10 | 11 | 12 |   |   |   |   |   |   |
| 5  |    |    |    |    |    |    |   |   |   |   |   |   |
| 6  | 18 | 17 | 16 | 15 | 14 | 13 |   |   |   |   |   |   |
| 7  |    |    |    |    |    |    |   |   |   |   |   |   |
| 8  | 19 | 20 | 21 | 22 | 23 | 24 |   |   |   |   |   |   |
| 9  |    |    |    |    |    |    |   |   |   |   |   |   |
| 10 | 30 | 29 | 28 | 27 | 26 | 25 |   |   |   |   |   |   |
| 11 |    |    |    |    |    |    |   |   |   |   |   |   |
| 12 | 31 | 32 | 33 | 34 | 35 | 36 |   |   |   |   |   |   |
| 13 |    |    |    |    |    |    |   |   |   |   |   |   |

I, James L. Schwandt, in a field survey on October 13, 1995, do hereby certify that under requirements of P.A. 74, Michigan P.A. of 1970, the corner points mentioned in lines 1 and 2 above were in conformance with regulations and rules therefore as required in the current manual of survey instructions of the United States Department of the Interior, Bureau of Land Management or by a decree of a Court of Law and/or that the corner points mentioned in lines 3, 4 and 5 above were in conformance with the rules of the Michigan Board of Professional Surveyors or by a Decree of a Court of Law; established, re-established, monumented, re-monumented, recovered, found as expressed below:

NOTE: Not more than 4 corners, all in the same town and range, may be recorded on this certificate.

A. Description of original monument and accessories and/or subsequent restoration:  
 A-4 T30N-R3W

G.L.O. Addison P. Brewer, 1856  
 Set Post  
 12" Birch S32°W 4 (2.64')  
 18" Hemlock N16°W 17 (11.22')

Gerald R. McKelvey #19001  
 June 10, 1975  
 Fd. 3/4" iron pipe & old blazes  
 Origin unknown, ± 5' South of E-W fence  
 Tag #19001 in 4" Aspen S52°E 63.45'  
 Tag #19001 in Blazed 10" Elm S16°E 42.02'  
 Tag #19001 in 4" Aspen N55°E 70.83'

Carl I. Robinson Set  
 O.C.M. from G.R.M. wit.

B. Description of corner evidence found and/or method applied in restoring or reestablishing corner:

A-4 Fd. O.C.M. set by C.I.R. from G.R.M. wit. G.R.M. Fd. 3/4" pipe & old blazes - Origin unknown. No tie to G.L.O. No wit Fd.

C. Description of monument for corner and accessories established to perpetuate locating the position of the corner:


A-4 Fd. O.C.M.

Cor. Fence Post Airport N87°E, 73.79'  
 Set Tag & Blz 6" Aspen S54°E 59.13'  
 Set Tag & Blz 4" Aspen S29°E  
 Set Tag & Blz 5" Cherry S85°W 85.22'

And is accepted as a careful and faithfull reestablishment of the position of the original corner.

OTSEGO COUNTY REMONUMENTATION

Approved by the County Survey Peer  
 Group, pursuant to Act 345, PA 1990.  
 Nov. 27, 1995 Date [Signature] Chairman

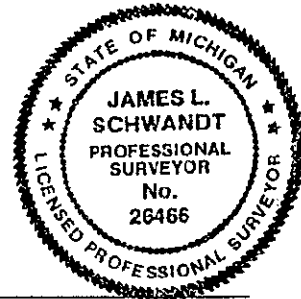

Signed by James L. Schwandt  
 James L. Schwandt, PS  
 Surveyor's Michigan License No. 26466

Date 11-22-95