

OTSEGO COUNTY REMONUMENTATION
LAND CORNER RECORDATION CERTIFICATE
 Filing Requirement of Act 74, Mich. P.A. 1970

LIBER 0004 PAGE 146


For corners in Otsego (County) Located In: _____ Corner Code # _____

1. Public Land Survey	T	<u>30N</u>	R	<u>3W</u>	<u>D-5</u>
	T	_____	R	_____	_____
	T	_____	R	_____	_____
	T	_____	R	_____	_____
2. Property Controlling in Section	S	_____	T	_____	_____
	S	_____	T	_____	_____
3. Miscellaneous Property in Section	S	_____	T	_____	_____
	S	_____	T	_____	_____

OTSEGO COUNTY MICHIGAN
 RECEIVED FOR RECORD
 95 DEC 27 AM 9:38
 EVELYN H. PRATT
 CLERK / REGISTER OF DEEDS

Register of Deeds Stamp & File Number

4. Lot No. _____, Recorded Plat _____
 5. Private Claims _____

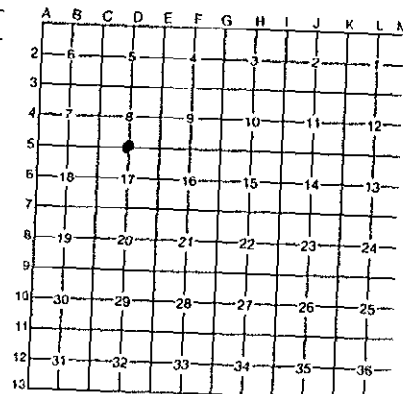

I, James L. Schwandt, in a field survey on October 10, 1995, do hereby certify that under requirements of P.A. 74, Michigan P.A. of 1970, the corner points mentioned in lines 1 and 2 above were in conformance with regulations and rules therefore as required in the current manual of survey instructions of the United States Department of the Interior, Bureau of Land Management or by a decree of a Court of Law and/or that the corner points mentioned in lines 3, 4 and 5 above were in conformance with the rules of the Michigan Board of Professional Surveyors or by a Decree of a Court of Law; established, re-established, monumented, re-monumented, recovered, found as expressed below:

NOTE: Not more than 4 corners, all in the same town and range, may be recorded on this certificate.

A. Description of original monument and accessories and/or subsequent restoration:

D-5 T30N-R3W

G.L.O. Addison Brewer, 1856
 Set Post
 7" Hemlock N21°E 16 (10.56')
 16" Beech S42°W 39 (25.74')

Gerald R. McKelvey #19001
 March 22, 1974 LCRC L.1 Pg.259
 Fd. Axle 6" below road in corner
 Tag in tree S30°W 33.1'
 6" Pine S40°E 63.47'
 Fence Post N50°W 55.48'

Carl I. Robinson
 Set O.C.M. based on G.R.M. LCRC.

B. Description of corner evidence found and/or method applied in restoring or reestablishing corner:

D-5 Found O.C.M. in Mon. Box set by C.I.R. based on G.R.M. LCRC L.1 Pg.259. G.R.M. stated in LCRC that the axle he found at corner was of unknown origin. No tie to G.L.O.
 Found P.K. in P.P. N12°E 31.85'
 Found Spk. in 10" R. Pine S40°E 63.53'


C. Description of monument for corner and accessories established to perpetuate locating the position of the corner:

D-5 Found O.C.M. in Mon. Box
 Found P.K. in P.P. N12°E 31.85'
 Found Spk. in 10" R. Pine S40°E 63.53'
 CTR Sq. Nut Top Hyd N01°W 53.00'
 Cor. Fence Steel Tube N55°E 65.30'

And is accepted as a careful and faithful reestablishment of the position of the original corner.

OTSEGO COUNTY REMONUMENTATION

Approved by the County Survey Feet Group, pursuant to Act 345, PA 1990.
James L. Schwandt
 Date _____ Chairman

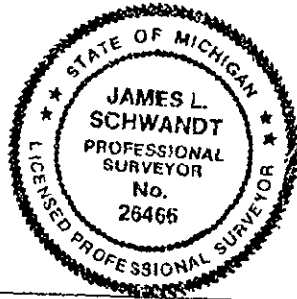

Signed by James L. Schwandt
 James L. Schwandt, PS
 Surveyor's Michigan License No. 26466

Date 11-22-95