

MAY 28 1997

OTSEGO COUNTY REMONUMENTATION

COMMISSION

LAND CORNER RECORDATION CERTIFICATE
Filing Requirement of Act 74, Mich. P.A. 1970
ALSO ACT 345, PA 1990

For corners in

Form with fields for Otsego (County), Located In: BAGLEY TOWNSHIP, Corner Code #: M-4, and numbered items 1-3 with T/R/S corner codes.

OTSEGO COUNTY MICHIGAN RECEIVED FOR RECORD 96 DEC 30 PM 2: 15 EVELYN M. PRATT CLERK / REGISTER OF DEEDS

Register of Deeds Stamp & File Number

4. Lot No. Recorded Plat
5. Private Claims

I, James L. Schwandt, in a field survey on Oct. 21, 1996 do hereby certify that under requirements of P.A. 74, Michigan P.A. of 1970, the corner points mentioned in lines 1 and 2 above were in conformance with regulations and rules therefore as required in the current manual of survey instructions of the United States Department of the Interior, Bureau of Land Management or by a decree of a Court of Law and /or that the corner points mentioned in lines 3, 4 and 5 above were in conformance with the rules of the Michigan Board of Land Surveyors or by a Decree of a Court of Law, established, re-established, monumented, re-monumented, recovered, found as expressed below:

Grid table with columns A-M and rows 1-13, containing numbers 1-36.

A. Description of original monument and accessories and/or subsequent restoration:

A-4 T30N-R2W
G.L.O. James H. Mullet, 1839
Set Post
12" Sugar S15°W, 34 Links (22.44')
12" Sugar N85°W, 32 Links (21.12')

CSR (2-274)
G. F. Delameter, 1922
48" W. Pine Stump N65°E, 99 Links (65.34')
40" W. Pine Stump S60°W, 55 Links (36.30")
36" W. Pine Stump N67°W, 98 1/2 Links (65.01')
Steel Ford Axle @ Corner
Fnd Both Government B's & P

CSR (3-262)
Delameter Fnd Axle
CM West, 34.07'
CM East, 33.65'
17" Maple N62°E, 45.40'
24" Maple Clump S35°E, 66.54'

\*SEE BACK FOR ADDITIONAL INFORMATION

CSR (1-37)
J.W. Sanborn, 1887
Hemlock 24" N68°E, 33 Links (22.44')
Sugar 12" N85°W, 32 Links (21.12')
Hemlock 24" N12°W, 17 Links (11.22')


CSR (3-263)
S. Thorson, 1968
MSHD Notes, 1966

B. Description of corner evidence found and/or method applied in restoring or reestablishing corner:

Fnd OCM ±1' Deep
Fnd Spk 12" Twin Maple N40°E, 24.00'
Fnd Old Blaze in 12" Tri. Maple and Set Spk N80°E, 16.63'
Fnd Old Blaze in 12" Tri. Maple and Set Spk N70°W, 29.10'

C. Description of monument for corner and accessories established to perpetuate locating the position of the corner:

OCM, and is accepted as a careful and faithful perpetuation of the position of the original corner.
Fnd Spk 12" Twin Maple N40°E, 24.00'
Fnd Old Blaze in 12" Tri. Maple and Set Spk N80°E, 16.63'
Fnd Old Blaze in 12" Tri. Maple and Set Spk N70°W, 29.10'
Set Spk in 14" Elm S85°W, 26.30'

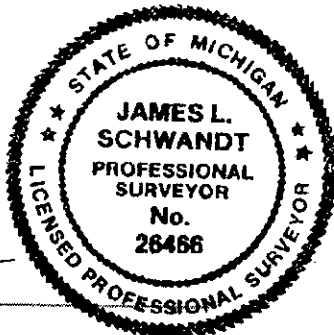

OTSEGO COUNTY REMONUMENTATION

Approved by the County Survey Peer Group, pursuant to Act 345, PA 1990.
Nov. 1, 1996 Date Chairman

Signed by James L. Schwandt
Surveyor's Michigan License No. 26466

Date 12-13-96