

LAND CORNER RECORDATION CERTIFICATE

Filing Requirement of Act 74, Mich. PA 1970

For Corners In: Otsego (County)	Located In	Corner Code #
1. Public Land Survey	T <u>30N</u> R <u>3W</u>	M-11
	T _____ R _____	_____
2. Property Controlling in Section	S <u>25</u> T <u>30N</u> R <u>3W</u>	16
	S _____ T _____ R _____	_____
3. Miscellaneous Property in Section	S _____ T _____ R _____	_____
	S _____ T _____ R _____	_____

Register of Deeds Stamp & File Number

4. Lot No: _____ Recorded Plat: _____

5. Private Claims: _____

I, Carl T. Kiiskila, in a field survey on July 23, 2001 do hereby state that under requirements of PA 74, Michigan PA of 1970, the corner points mentioned in lines 1 and 2 above were in conformance with regulations and rules therefore as required in the current manual of survey instructions of the United States Department of the Interior, Bureau of Land Management or by a decree of a Court of Law and/or that the corner points mentioned in lines 3, 4 and 5 above were in conformance with the rules of the Michigan Board of Land Surveyors or by a Decree of a Court of Law; established, re-established, monumented, recovered, found as expressed below:

NOTE: Not more than 2 corners, all in the same town and range, may be recorded on this certificate.

	A	B	C	D	E	F	G	H	I	J	K	L	M
1													
2	6		5		4		3		2		1		
3													
4	7		8		9		10		11		12		
5													
6	18		17		16		15		14		13		
7													
8	19		20		21		22		23		24		
9													
10	30		29		28		27		26		25		
11													
12	31		32		33		34		35		36		
13													

A. Description of original monument and accessories and/or subsequent restoration:


M-11 G.L.O. James H. Mullet D.S. 1839
Set post corner section 25 and 36
Wit: Beech 12 N80°W 14 links
Beech 6 S26°w 28 links

16 This corner position was not established during the original government survey.

B. Description of corner evidence found and/or method applies in restoring or re-establishing corner:

M-11 Found capped "T" iron RLS #6525 and carsonite post

16- Found a capped "T" iron RLS #6525

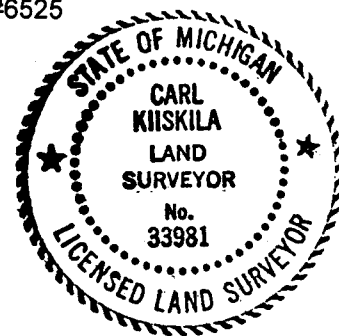

C. Description of monument for corner and accessories established to perpetuate locating the position of the corner:

M-11 Found capped "T" iron RLS #6525 and carsonite post
Wit: *16" Red Pine N33°W 15.96'
6" White Pine S37°W 21.13'
4" White Pine N78°E 41.87'
*6" White Pine N20°E 73.42'
*Old pine stump w/ tag RLS #6525 S70°E 16.29'
* Old witnesses by others

16- Found capped "T" iron RLS #6525
Wit: 12" Red Pine East 26.04'
10" Red Pine N55°E 35.73'
6"&8" Twin Red Pine N35°E 33.36'
6" Cherry S76°W 33.74'
*Old Pine stump w/ tag RLS #6525 S37°W 3.67'
Carsonite Post North 1'±
*Old witnesses by others

Signed by: Carl T. Kiiskila
Surveyor's Michigan License No.: 33981

Date: 8-30-01