

LAND CORNER RECORDATION CERTIFICATE

Filing Requirement of Act 74, Mich. PA 1970

For Corners In:
Otsego Located In _____ Corner Code # _____
 (County)

1. Public Land Survey T _____ R _____
 T _____ R _____
 2. Property Controlling in Section S 13 T 30N R 4W 1
 S _____ T _____ R _____
 3. Miscellaneous Property in Section S _____ T _____ R _____
 S _____ T _____ R _____

4. Lot No: _____ Recorded Plat: _____

5. Private Claims: _____

I, Carl T. Kiiskila, in a field survey on June 23, 2003 do hereby state that under requirements of PA 74, Michigan PA of 1970, the corner points mentioned in lines 1 and 2 above were in conformance with regulations and rules therefore as required in the current manual of survey instructions of the United States Department of the Interior, Bureau of Land Management or by a decree of a Court of Law and/or that the corner points mentioned in lines 3, 4 and 5 above were in conformance with the rules of the Michigan Board of Land Surveyors or by a Decree of a Court of Law, established, re-established, monumented, recovered, found as expressed below:

NOTE: Not more than 2 corners, all in the same town and range, may be recorded on this certificate.

A. Description of original monument and accessories and/or subsequent restoration:



1- James L. Schwandt P.S. #26466 set this corner while doing a survey in section 13.

B. Description of corner evidence found and/or method applies in restoring or re-establishing corner:

1- Found 1/2" iron with P.S. cap # 26466 as set by J.L. Schwandt.

C. Description of monument for corner and accessories established to perpetuate locating the position of the corner:

1- 1/2" iron with P.S. cap #26466
 Wit: 14" W. Pine N70°W 44.19'
 13" W. Pine N50°W 39.75'
 13" R. Pine N10°W 87.63'
 Centerline of Co. Rd East 40.2'
 Blue Carsonite Post North 1'±

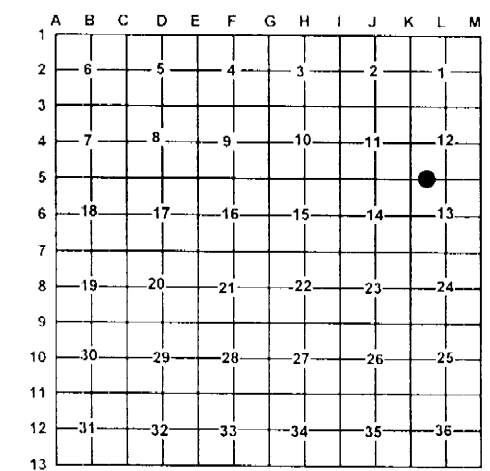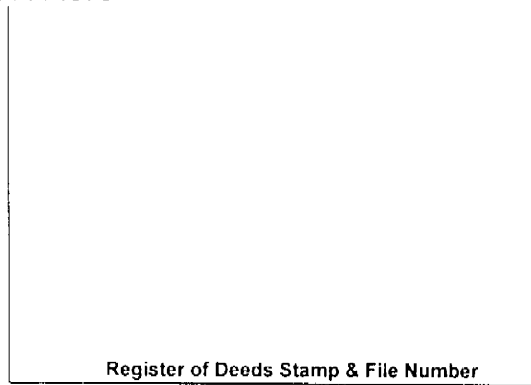

Signed by: Carl T. Kiiskila
 Surveyor's Michigan License No.: 33981

Date: 7-21-04