

**LAND CORNER RECORDATION CERTIFICATE**  
**Filing Requirement of Act 74, Mich. P.A. 1970**

For corners in

<u>Otsego</u> <small>(County)</small>	Located In:	Corner Code #:
1. Public Land Survey	T <u>31</u> R <u>1W</u>	<u>L-12</u>
	T _____ R _____	_____
	T _____ R _____	_____
	T _____ R _____	_____
2. Property Controlling in Section	S <u>36</u> T <u>31</u> R <u>1W</u>	<u>4</u>
	S <u>36</u> T <u>31</u> R <u>1W</u>	<u>8</u>
<del>3. Miscellaneous Property in Sec.</del>	S <u>36</u> T <u>31</u> R <u>1W</u>	<u>15</u>
	S _____ T _____ R _____	_____

Register of Deeds Stamp & File Number

4. Lot No. \_\_\_\_\_, Recorded Plat \_\_\_\_\_  
 5. Private Claims \_\_\_\_\_

I, Carl Johnson, in a field survey on September 19, 19 91, do hereby certify that under requirements of P.A. 74, Michigan P.A. of 1970, the corner points mentioned in lines 1 and 2 above were in conformance with regulations and rules therefore as required in the current manual of survey instructions of the United States Department of the Interior, Bureau of Land Management or by a decree of a Court of Law and/or that the corner points mentioned in lines 3, 4 and 5 above were in conformance with the rules of the Michigan Board of Land Surveyors or by a Decree of a Court of Law; established, re-established, monumented, re-monumented, recovered, found as expressed below:

**NOTE: Not more than 4 corners, all in the same town and range, may be recorded on this certificate.**

A. Description of original monument and accessories and/or subsequent restoration:


B. Description of corner evidence found and/or method applied in restoring or reestablishing corner:

- L-12 - Set at computed intersection of  $\frac{1}{4}$  line.
- 4 - Set by standard survey procedure for subdivision of a section.
- 8 - Set by standard survey procedure for subdivision of a section.
- 15 - Set by standard survey procedure for subdivision of a section.

C. Description of monument for corner and accessories established to perpetuate locating the position of the corner:

<u>L-12: Center of Sec 36</u>	<u>4: Center of NW<math>\frac{1}{4}</math> Sec 36</u>	<u>8: W 1/8 Corner on E-W <math>\frac{1}{4}</math> Line</u>	<u>15: W 1/8 Cor on S Line Sec</u>
Set DNR mon & Cedar post	5/8" Rerod w/cap & Cedar post	5/8" Rerod w/cap & Cedar post	5/8" Rerod w/cap & Cedar post
Twin Maple 7" N88°E 5.9'	Oak 14" S70°W 10.4'	Maple 8" N09°E 14.9'	Triple Maple 8" N71°W 23.8'
Oak 7" S41°E 8.1'	Twin Oak 9" N27°E 24.3'	Maple 6" S64°E 19.9'	Twin Oak 10" N03°E 20.5'
Oak 12" N73°W 5.6'	Oak 10" S76°E 24.5'	Beech 12" S32°W 5.0'	Oak 8" N56°E 18.2'
Maple 5" N13°E 9.6'	Upper & Lower blazes w/scribes	Upper & Lower blazes w/scribes	Oak 20" S12°E 31.5'
Upper & Lower blazes w/scribes			$\frac{1}{2}$ " Rerod S71°E 32.3'
			Upper & Lower blazes w/scri

A	B	C	D	E	F	G	H	I	J	K	L	M
2	6	5	4	3	2	1						
3												
4	7	8	9	10	11	12						
5												
6	18	17	16	15	14	13						
7												
8	19	20	21	22	23	24						
9												
10	30	29	28	27	26	25						
11												
12	31	32	33	34	35	36						
13												

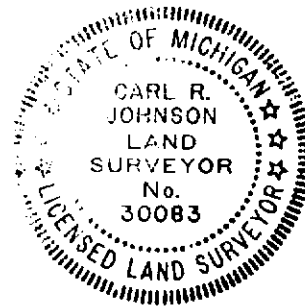

Signed by Carl Johnson Date 1/28/92  
 Surveyor's Michigan License No. 30083