

SURVEY & REMONUMENTATION

MAY 28 1997

COMMISSION

OTSEGO COUNTY REMONUMENTATION
LAND CORNER RECORDATION CERTIFICATE
Filing Requirement of Act 74, Mich. P.A. 1970
ALSO Act 345, PA 1990

OTSEGO COUNTY
MICHIGAN
RECEIVED FOR RECORD
96 DEC 30 PM 2:17
EVELYN M. PRATT
LERK / REGISTER OF DEEDS

For corners in

OTSEGO	Located In:	Corner Code #
(County)	Elmira Township	
1. Public Land Survey	T 31 N R 4 W	E-8
	T R	
	T R	
	T R	
2. Property Controlling in Section	S T R	
	S T R	
3. Miscellaneous Property in Sec.	S T R	
	S T R	

Register of Deeds Stamp & File Number

4. Lot No. _____, Recorded Plat _____
5. Private Claims _____

I, Carl I. Robinson, in a field survey on December 4, 1996 do hereby state that under requirements of P.A. 74, Michigan P.A. of 1970, the corner points mentioned in lines 1 and 2 above were in conformance with regulations and rules therefore as required in the current manual of survey instructions of the United States Department of the Interior, Bureau of Land Management or by a decree of a Court of Law and /or that the corner points mentioned in lines 3, 4 and 5 above were in conformance with the rules of the Michigan Board of Land Surveyors or by a Decree of a Court of Law; established, re-established, monumented, recovered, found as expressed below:

NOTE: Not more than 2 corners, all in the same town and range, may be recorded on this certificate.

	A	B	C	D	E	F	G	H	I	J	K	L	M
1													
2	6		5		4		3		2				
3													
4	7		8		9		10		11		12		
5													
6	18		17		16		15		14		13		
7													
8	19		20		21		22		23		24		
9													
10	30		29		28		27		26		25		
11													
12	31		32		33		34		35		36		
13													

A. Description of original monument and accessories and/or subsequent restoration:


- GLD 2/408: Austin Burt, 1850: Set Qr. Post-Sugar 14" S 18°E 13 lks (8.6'), Sugar 14" S 25°W 40 lks (26.4').
- CSR 1/25: W.F. Sanborn, 1888: Sugar 14" S 22°W 40 lks (26.4'), Sugar 16" S 86°W 29½ lks (19.5'). Also on same page in different hand Elm 16" N 57°E 80 lks (52.8'), School House N 45½°W 159 lks (104.9').
- CSR 1/34: J.M. Sanborn, 1886: Sugar 14" S 25°W 40 lks (26.4'), Sugar 20" S 87°W 30 lks (19.8').
- CSR 2/410: G.F. DeLaMater, 1930: Found Hoffman's old Post & roots of B., School House gone, ½"x30" bar in corner- Elm 4" N 89°E 44.7', Concrete Monument N 87°W 43.0'.
- LCRC 3/125: C.C. Lindgren, 1993: Found small Boat Spike 1' deep-FePost N 85°E 36.14', Fe.Post S 35°E 46.96', 21" Poplar S 80°W 32.34', 16" Poplar West 37.00'.
- Survey 603/791: J.L. Schwandt, 1996: Found Boat Spike-Fe.Post East 36.6', 30" Cottonwood S 68°W 32.47', T Bar 3920 West 32.88'.

B. Description of corner evidence found and/or method applied in restoring or reestablishing corner:

Found Boat Spike 1" deep over ½" Iron Rod, Stump of DeLaMater's Elm, Feindt's T Bar and all of Lindgren's references (Fence Posts are very fragile therefore I did not use).

C. Description of monument for corner and accessories established to perpetuate locating the position of the corner:

Set Otsego County Monument over ½" Iron Rod and is accepted as a careful and faithful perpetuation of the position of the original corner-½" Capped (26466) Iron Rod S 89°E 33.00', MDOT Tag 24" Cottonwood S 68°W 32.42', T Bar 3920 West 32.88', MDOT Tag 16" Cottonwood S 85°W 37.00'.

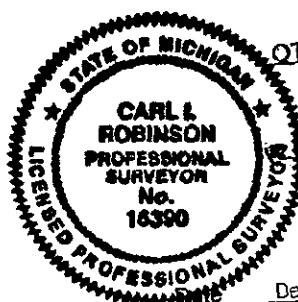

OTSEGO COUNTY REMONUMENTATION
Approved by the County Survey Peer Group, pursuant to Act 345, PA 1990.
Date 12/11/96
V. S. [Signature]

Signed by Carl I. Robinson
Surveyor's Michigan License No. 16390

December 11, 1996