

**SURVEY &  
REMONUMENTATION**

MAY 28 1997

COMMISSION

**OTSEGO COUNTY REMONUMENTATION  
LAND CORNER RECORDATION CERTIFICATE  
Filing Requirement of Act 74, Mich. P.A. 1970  
ALSO Act 345, PA 1990**

For corners in

OTSEGO <small>(County)</small>	Located In:	Corner Code #
	Elmira Township	
1. Public Land Survey	T <u>31</u> N R <u>4</u> W	I-6
	T <u>   </u> R <u>   </u>	_____
	T <u>   </u> R <u>   </u>	_____
	T <u>   </u> R <u>   </u>	_____
2. Property Controlling in Section	S <u>   </u> T <u>   </u> R <u>   </u>	_____
	S <u>   </u> T <u>   </u> R <u>   </u>	_____
3. Miscellaneous Property in Sec.	S <u>   </u> T <u>   </u> R <u>   </u>	_____
	S <u>   </u> T <u>   </u> R <u>   </u>	_____

**OTSEGO COUNTY  
MICHIGAN  
RECEIVED FOR RECORD**  
**96 DEC 30 PM 2:19**  
EVELYN M. PRATT  
CLERK / REGISTER OF DEEDS

**Register of Deeds Stamp & File Number**

4. Lot No. \_\_\_\_\_, Recorded Plat \_\_\_\_\_  
5. Private Claims \_\_\_\_\_

I, Carl I. Robinson, in a field survey on December 11, 1996 do hereby state that under requirements of P.A. 74, Michigan P.A. of 1970, the corner points mentioned in lines 1 and 2 above were in conformance with regulations and rules therefore as required in the current manual of survey instructions of the United States Department of the Interior, Bureau of Land Management or by a decree of a Court of Law and/or that the corner points mentioned in lines 3, 4 and 5 above were in conformance with the rules of the Michigan Board of Land Surveyors or by a Decree of a Court of Law; established, re-established, monumented, recovered, found as expressed below:


	A	B	C	D	E	F	G	H	I	J	K	L	M
1													
2		6		5		4		3		2		1	
3													
4		7		8		9		10		11		12	
5													
6		18		17		16		15		14		13	
7													
8		19		20		21		22		23		24	
9													
10		30		29		28		27		26		25	
11													
12		31		32		33		34		35		36	
13													

**NOTE:** Not more than 2 corners, all in the same town and range, may be recorded on this certificate.

**A. Description of original monument and accessories and/or subsequent restoration:**  
 GLO 2/402: Austin Burt. 1850: Set Qr. Section Post-Sugar 8" East 14 lks (9.2'), Sugar 8" S 54½W 5lks (3.3').  
 CSR 1/12: J.M Sanborn, 1881: Pine Post with broken Plow Point & stones around it-Sugar 20" S 41½W 38 lks (25.1'), Sugar 20" N 15°W 50½ lks (33.3').  
 CSR 2/464: G.F. DeLaMater, 1931: Concrete Monument East 34.0'.  
 LCRC 2/327: C.I. Robinson, 1985: Found 1½" Iron Pipe 10" deep & DeLaMater's Concrete Monument East, set Otsego County Monument over Pipe-Concrete Monument (bent) East 33.10', 24" S.Maple S 08°E 140.20', U.Pole S 14°W 185.69', U.Pole N 10°W 179.12'.

**B. Description of corner evidence found and/or method applied in restoring or reestablishing corner:**  
 Found Otsego County Monument, DeLaMater's Monument (bent) East, and all my 1985 references. Traverse to north & south indicate corner is 2.4' west & 1.3' south of the single proportional position. This precision is closer than expected in hilly terrain for original government surveys, therefore, I believe DeLaMater reestablished the corner in 1931.

**C. Description of monument for corner and accessories established to perpetuate locating the position of the corner:**  
 Otsego County Monument 5' east of centerline of pavement, and is accepted as a careful and faithful reestablishment of the position of the original corner-Concrete Monument (bent) N 85°E 33.22', spk 4"x4" Tel.Term.Post S 49°E 34.70', spk Tw.12" Box Elder S 47°W 95.41', spk 6" Blue Spruce West 60.97'.

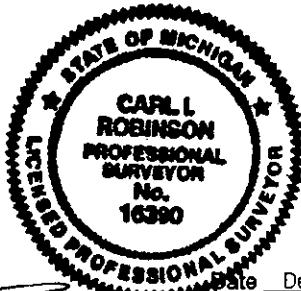

**OTSEGO COUNTY REMONUMENTATION**  
 Approved by the County Survey Peer Group, pursuant to Act 345, PA 1990.  
Dec 13 1996 David E. Sagan  
 Date V. Chairman

Signed by Carl I. Robinson Date December 12, 1996  
 Surveyor's Michigan License No. 16390