

SURVEY & REMONUMENTATION

LIBER 0004 PAGE 11

MAY 28 1997

COMMISSION

**OTSEGO COUNTY REMONUMENTATION
LAND CORNER RECORDATION CERTIFICATE
Filing Requirement of Act 74, Mich. P.A. 1970
ALSO Act 345, PA 1990**

For corners in

OTSEGO
(County)

Located in:

Corner Code #

Elmira Township

1. Public Land Survey

T 31 N R 4 W

1-9

2. Property Controlling in Section

S

T R

3. Miscellaneous Property in Sec.

S

T R

S

T R

S

T R

S

T R

4. Lot No. _____, Recorded Plat _____

5. Private Claims _____

OTSEGO COUNTY
MICHIGAN
RECEIVED FOR RECORD

96 DEC 30 PM 2:19

EVILYN M. PRATT
CLERK / REGISTER OF DEEDS

Register of Deeds Stamp & File Number

I, Carl I. Robinson, in a field survey on December 11, 1996 do hereby state that under requirements of P.A. 74, Michigan P.A. of 1970, the corner points mentioned in lines 1 and 2 above were in conformance with regulations and rules therefore as required in the current manual of survey instructions of the United States Department of the Interior, Bureau of Land Management or by a decree of a Court of Law and/or that the corner points mentioned in lines 3, 4 and 5 above were in conformance with the rules of the Michigan Board of Land Surveyors or by a Decree of a Court of Law; established, re-established, monumented, recovered, found as expressed below:

NOTE: Not more than 2 corners, all in the same town and range, may be recorded on this certificate.

1	A	B	C	D	E	F	G	H	I	J	K	L	M
2	6		5		4		3		2		1		
3													
4	7		8		9		10		11		12		
5													
6	18		17		16		15		14		13		
7													
8	19		20		21		22		23		24		
9													
10	30		29		28		27		26		25		
11													
12	31		32		33		34		35		36		
13													

A. Description of original monument and accessories and/or subsequent restoration:


- GLD 2/398: Austin Burt, 1850: Set Post-Beech 8" N 32°E 35 lks (23.1'), Beech 8" S 50°W 06 lks (4.0').
- CSR 1/18 & 28: J.M. Sanborn, 1883 & 84: Hemlock 15" N 47°E 49 lks (32.3'), Hemlock 15" S 36°E 25½ lks (16.8').
- CSR 1/88: A.W. Bates, 1895: Set Long Post in Road by measurement N & S with Old Blazes to the west-Pine S 30" N 49°W 124 lks (81.8'), Post 50 lks East & 50 lks South.
- CSR 1/110: D.M. Hoffman, 1908±: Old Pine Stump N 49°W 119½ lks (78.9').
- CSR 2/234: G.F. DeLaMater, 1932: Found Bates B & P, Set Gas Pipe in Corner-Culvert H.W. N 12°E 84.5', Concrete Monument S 63°E 79.7', B.Cherry 5" S 38°E 59.2', Concrete Monument N 63°W 79.7', Culvert H.W. N 12½°W 85.4'
- LCRC 1/213: G.R. McKelvey, 1973: Found ½" Iron Rod & DeLaMater's Monuments-Concrete Monument S 63°E 79.7', P.Pole S 45°W 85.5', Concrete Monument N 63°W 79.75'.
- LCRC 3/127: C.C. Lindgren, 1993: Found ½" Rod in Mon.Box 4' E of M-32 Q-14" R.Pine N 60°E 80.24', 7" Maple S 40°W 97.86', 16" R.Pine S 43°W 83.43', P.Pole N 60°W 89.80'.

B. Description of corner evidence found and/or method applied in restoring or reestablishing corner:

Found ½" Iron Rod in Mon. Box, DeLaMater's Monuments SE & NW, both Culvert H.W.s, and Lindgren's R.Pine NE, Maple (Elm) SW, & P.Pole NW.

C. Description of monument for corner and accessories established to perpetuate locating the position of the corner:

½" Iron Rod in Mon. Box 4'± east of centerline of M-32 pavement, and is accepted as a careful and faithful reestablishment of the position of the original corner-MDOT tag 14" R.Pine N 49°E 80.24', Concrete Monument S 63°E 79.56', MDOT tag 7" Elm S 39°W 97.86', MDOT tag P.Pole N 68°W 89.80', Concrete Monument N 63°W 79.55'.

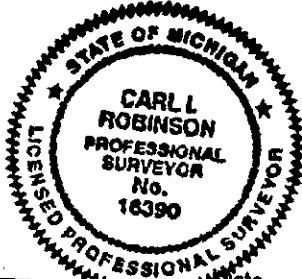

OTSEGO COUNTY REMONUMENTATION

Approved by this County Survey Peer Group, pursuant to Act 345, PA 1990.

Date 12/13/96 Daniel E. Sagan, Chairman

Signed by Carl I. Robinson
Surveyor's Michigan License No. 16390

Date December 12, 1996