

LAND CORNER RECORDATION CERTIFICATE

Filing Requirement of Act 74, Mich. PA 1970

For Corners In:
OTSEGO Located In _____ Corner Code # _____
 (County)

1. Public Land Survey T _____ R _____
 T _____ R _____

2. Property Controlling in Section
 S 32 T 32N R 1W 6
 S 32 T 32N R 1W 7

3. Miscellaneous Property in Section
 S _____ T _____ R _____
 S _____ T _____ R _____

4. Lot No: _____ Recorded Plat: _____

5. Private Claims: _____

I, Carl T. Kiiskila, in a field survey on January 5, 2010 do hereby state that under requirements of PA 74, Michigan PA of 1970, the corner points mentioned in lines 1 and 2 above were in conformance with regulations and rules therefore as required in the current manual of survey instructions of the United States Department of the Interior, Bureau of Land Management or by a decree of a Court of Law and/or that the corner points mentioned in lines 3, 4 and 5 above were in conformance with the rules of the Michigan Board of Land Surveyors or by a Decree of a Court of Law; established, re-established, monumented, recovered, found as expressed below:

NOTE: Not more than 2 corners, all in the same town and range, may be recorded on this certificate.

A. Description of original monument and accessories and/or subsequent restoration:

6 NE 1/16 Corner, Section 32, T32N,R1W 7 N 1/16 Cor. comm. to sec.'s 32 & 33, T32N,R1W
 None None


B. Description of corner evidence found and/or method applies in restoring or re-establishing corner:

6 NE 1/16 Corner, Section 32, T32N,R1W 7 N 1/16 Cor. comm. to sec.'s 32 & 33, T32N,R1W
 Set stamped 2" dia. aluminum cap on 5/8"x34" rebar per standard BLM procedure. Found 1 1/4" galvanized pipe standing up 6.3' above ground at a bearing and distance of S79°W 9.02' from calculated position for corner. Found no other evidence to dispute the location for the corner. Found 1 1/2" pipe with P.K. nail in center of pipe on West edge of a gravel county road. Accepted found pipe as the best available evidence for the position of the corner. Found no other evidence to dispute the location for the corner. Added 1/2" plastic P.S. cap#33981 over P.K. in center of pipe.

C. Description of monument for corner and accessories established to perpetuate locating the position of the corner:

6 NE 1/16 Corner, Section 32, T32N,R1W 7 N 1/16 Cor. comm. to sec.'s 32 & 33, T32N,R1W
 Stamped 2" dia. aluminum cap on 5/8"x34" rebar. 1 1/2" pipe with P.K. and plastic P.S. cap#33981 in center.
 Wit: S27°E 22.53' to set N&T on W side 4" R.Pine
 S13°W 22.91' to set N&T on W side 13" J.Pine
 N78°W 8.19' to set N&T on SW side 16" R.Pine
 N30°W 14.47' to set N&T on E side 19" R.Pine
 S79°W 9.02' to fd. 1 1/4" x 6.3' galv. pipe
 Set Blue Carsonite Post w/location tag 1' North
 Wit: S79°E 35.07' to set N&T on NE side 13" W.Pine
 S09°E 91.47' to set N&T on E side P.Pole
 N61°W 20.31' to set N&T on S side 22" R.Pine
 N05°W 29.44' to set N&T on E side 9" R.Pine
 Set Blue Carsonite Post w/location tag 10' West

Register of Deeds Stamp & File Number

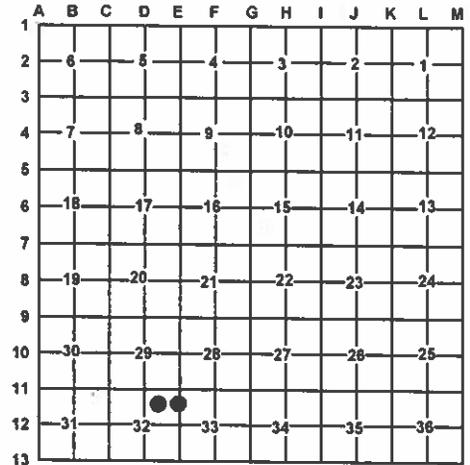

Carl T. Kiiskila

Surveyor's Michigan License No.: 33981



10-26-10