

MAY 28 1997

OTSEGO COUNTY REMONUMENTATION

COMMISSION

LAND CORNER RECORDATION CERTIFICATE
Filing Requirement of Act 74, Mich. P.A. 1970
ALSO ACT 345, PA 1990

For corners in

Otsego

(County)

Located in: CORWITH TOWNSHIP Corner Code #

- 1. Public Land Survey T32N R2W A-1
T___ R___
T___ R___
T___ R___
- 2. Property Controlling in Section S___ T___ R___
S___ T___ R___
- 3. Miscellaneous Property in Sec. S___ T___ R___
S___ T___ R___

OTSEGO COUNTY MICHIGAN RECEIVED FOR REC

96 DEC 30 PM 2:21
EVELYN H. PRATT
CLERK / REGISTER OF DEEDS

Register of Deeds Stamp & File Number

- 4. Lot No. _____, Recorded Plat _____
- 5. Private Claims _____

I, James L. Schwandt, in a field survey on Oct. 22, 1996 do hereby certify that under requirements of P.A. 74, Michigan P.A. of 1970, the corner points mentioned in lines 1 and 2 above were in conformance with regulations and rules therefore as required in the current manual of survey instructions of the United States Department of the Interior, Bureau of Land Management or by a decree of a Court of Law and for that the corner points mentioned in lines 3, 4 and 5 above were in conformance with the rules of the Michigan Board of Land Surveyors or by a Decree of a Court of Law, established, re-established, monumented, re-monumented, recovered, found as expressed below:

	A	B	C	D	E	F	G	H	I	J	K	L	M
1													
2		6		5		4		3		2		1	
3													
4		7		8		9		10		11		12	
5													
6		18		17		16		15		14		13	
7													
8		19		20		21		22		23		24	
9													
10		30		29		28		27		26		25	
11													
12		31		32		33		34		35		36	
13													

A. Description of original monument and accessories and/or subsequent restoration:


- G.L.O. (2-344) John Mullett, 1840 Set Section Cor Post Set Post for Cor to T32&33N, R2&3W 8" Sugar S76°E, 27 Links (17.82') 14" Hemlock N26°W, 31 Links (20.46')
- CSR (3-448) MSHD by Thorsen (59) 1/2" Rod in Concrete 5" Balsam N12°E, 19.65' 11" Cedar N80°E, 30.40' 7" Balsam S11°E, 5.25'
- Cheboygan Co. LCRC (A-68) Dean Delamater (1960) Fnd 1/2" Rod in Concrete 5" Fir N12°E, 19.65' 7" Fir S11°E, 5.25' 11" Cedar N80°E, 30.40'
- Cheboygan Co. Remonumentation Brian Fulford 8/96 L10, P201 Set 5/8" Rebar w/Remonumentation Cap in Center of 3 Cedar Stakes 15" Poplar N58°E, 11.32' 15" Poplar S24°E, 40.00' 9" Spruce S31°W, 32.25' 15" Poplar N48°W, 39.87' Fnd Remnants of Delamaters Witnesses

B. Description of corner evidence found and/or method applied in restoring or reestablishing corner:

Fnd 5/8" Rebar w/Cheboygan Co. Remon. Cap and all Witnesses by Brian Fulford

C. Description of monument for corner and accessories established to perpetuate locating the position of the corner:

5/8" x 36" rebar w/Cheboygan Co. Remon Cap, and is accepted as a careful & faithful reestablishment of the position of the original corner.
15" Poplar N58°E, 11.32'
15" Poplar S24°E, 40.00'
9" Spruce S31°W, 32.25'
15" Poplar N48°W, 39.87'

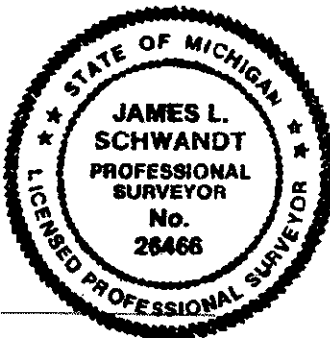

OTSEGO COUNTY REMONUMENTATION

Approved by the County Survey Peer Group, pursuant to Act 345, PA 1990.

DEC. 13, 1996 Date Chairman

Signed by James L. Schwandt

Surveyor's Michigan License No. 26466

Date 12-20-96