

MAR 17 2000

OTSEGO COUNTY REMONUMENTATION

SECTION

LAND CORNER RECORDATION CERTIFICATE
Filing Requirement of Act 74, Mich. P.A. 1970
Also Act 345, PA 1990

OTSEGO COUNTY
MICHIGAN
RECEIVED FOR RECORD
00 JAN 10 AM 10:08
EVELYN M. PRATT
CLERK / REGISTER OF DEEDS

For corners in

<u>Otsego</u> (County)	Located in: Corwith Township	Corner Code #
1. Public Land Survey	T <u>32N</u> R <u>2W</u>	<u>B-1</u>
	T _____ R _____	_____
	T _____ R _____	_____
	T _____ R _____	_____
2. Property Controlling in Section	S _____ T _____ R _____	_____
	S _____ T _____ R _____	_____
3. Miscellaneous Property in Sec.	S _____ T _____ R _____	_____
	S _____ T _____ R _____	_____
4. Lot No. _____, Recorded Plat _____		
5. Private Claims _____		

Register of Deeds Stamp & File Number

I, James L. Schwandt, in a field survey on Jan. 19, 1999, do hereby state that under requirements of P.A. 74, Michigan P.A. of 1970, the corner points mentioned in lines 1 and 2 above were in conformance with regulations and rules therefore as required in the current manual of survey instructions of the United States Department of the Interior, Bureau of Land Management or by a decree of a Court of Law and/or that the corner points mentioned in lines 3, 4 and 5 above were in conformance with the rules of the Michigan Board of Land Surveyors or by a Decree of a Court of Law; established, re-established, monumented, recovered, found as expressed below:

NOTE: Not more than 4 corners, all in the same town and range, may be recorded on this certificate.

1	A	B	C	D	E	F	G	H	I	J	K	L	M
2		6		5		4		3		2		1	
3													
4		7		8		9		10		11		12	
5													
6		18		17		16		15		14		13	
7													
8		19		20		21		22		23		24	
9													
10		30		29		28		27		26		25	
11													
12		31		32		33		34		35		36	
13													


A. Description of original monument and accessories and/or subsequent restoration:

B-1, T32N-R2W
G.L.O. John Mullett
May 20, 1840
Set Qrt Section Post
Hemlock 20" N22°E, 25 links (16.50')
Beech 12" N71°W, 44 links (29.04')

GF Delamater, 1935 (CSR3-12)
Found what might be Gov't bearing
tree, but not sure, may be
line tree

Stanley Thorsen, 1962 (CSR 3-12)
Set 1/2" bar at single pro.
4" Elm, S20°E, 19.4'
10" Beech, West 9.7'
9" Beech, N02°E, 19.8'
6" Elm N62°E, 22.7'

James L. Schwandt #26466, 1982, LCRC
1/2" bar w/squared cedar post
16" Beech West 10.20'
12" Beech N02°E, 20.50'
10" Beech N38°E, 11.90'
5" Maple S77°E, 6.00'

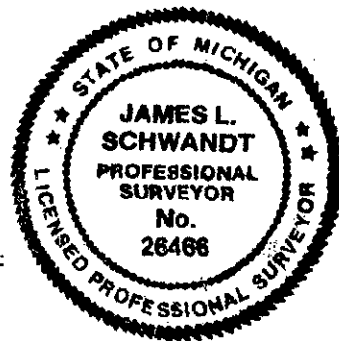

B. Description of corner evidence found and/or method applied in restoring or reestablishing corner:

Found 1/2" X 36" iron w/squared cedar post and three Beech witnesses

16" Beech West 10.20'
12" Beech N02°E, 20.50'
10" Beech, N38°E, 11.90'

OTSEGO COUNTY REMONUMENTATION

Approved by the County Survey Peer
Group, pursuant to Act 345, PA 1990
Dec. 22, 1999
Date Chairman

C. Description of monument for corner and accessories established to perpetuate locating the position of the corner:

Set Otsego County Monument and is accepted as a careful and faithful reestablishment of the position of the original corner.
16" Beech West 10.20'
12" Beech N2°E, 20.50'
10" Beech N38°E, 11.90'
6" Beech S40°E, 13.88'

Signed by James L. Schwandt Date 12-28-99
Surveyor's Michigan License No. 26466