

MAR 17 2000

OTSEGO COUNTY REMONUMENTATION

SECTION

LAND CORNER RECORDATION CERTIFICATE
Filing Requirement of Act 74, Mich. P.A. 1970
Also Act 345, PA 1990

OTSEGO COUNTY MICHIGAN RECEIVED FOR RECORD

00 JAN 10 AM 10:10

EVELYN H. PRATT CLERK / REGISTER OF DEEDS

For corners in

Form with columns: Otsego (County), Located In: Corwith Township, Corner Code #. Includes sections for Public Land Survey, Property Controlling in Section, Miscellaneous Property in Sec., Lot No., and Private Claims.

Register of Deeds Stamp & File Number

Grid table with columns A-M and rows 1-13. A dot is marked at the intersection of column C and row 1.

I, James L. Schwandt, in a field survey on Jan. 19, 1999, do hereby state that under requirements of P.A. 74, Michigan P.A. of 1970, the corner points mentioned in lines 1 and 2 above were in conformance with regulations and rules...

NOTE: Not more than 4 corners, all in the same town and range, may be recorded on this certificate.

A. Description of original monument and accessories and/or subsequent restoration:

C-1, T32N-R2W Stanley Thorson, 1962 (CSR3-12) James L. Schwandt #26466, 1982, L.C.R.C.
G.L.O. John Mullett Conc. Mon (Set) Set O.C.M. over Concrete Mon.
May 20, 1840 Elm 4" N82°W, 34.80' 14" Beech, N74°E, 59.40'
Beech 12" N37°W, 14 links (9.24') 26" Elm Stump N52 1/2°W, 55.56'
Sugar 10" N53°E, 47 links (31.02') 14" Poplar N76°W, 28.80'
7" Maple S51°E, 13.30'


Delamater 1933 (CSR3-12)
Elm 8" N52 1/2°W, 55.40'
Beech 12" N74°E, 59.50'
Sugar Stump NE, could be G.L.O.

B. Description of corner evidence found and/or method applied in restoring or reestablishing corner:

Found broken Otsego County Monument set by James L. Schwandt in 1982 over concrete monument
26" Elm stump N52°30'W, 55.56' (GFD)
14" Poplar N76°W, 28.80'
7" Maple, S51°E, 13.30'
14" Beech, Found stump @ distance & bearing (GFD)

C. Description of monument for corner and accessories established to perpetuate locating the position of the corner:

Re-set new Otsego County Monument in corner and is accepted as a careful and faithful perpetuation of the position of the original corner.
18" Elm N85°E, 55.15'
26" Elm stump N52°30'W, 55.56'
14" Poplar N76°W, 28.80'
9" Maple S51°E, 13.30'
OTSEGO COUNTY REMONUMENTATION
Approved by the County Survey Peer Group, pursuant to Act 345, PA 1990.
Date 12-29-1999 Chairman

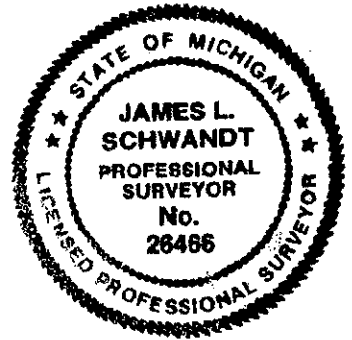

Signed by James L. Schwandt Date 12-28-99
Surveyor's Michigan License No. 26466