

MAR 17 2000

OTSEGO COUNTY REMONUMENTATION

LAND CORNER RECORDATION CERTIFICATE
Filing Requirement of Act 74, Mich. P.A. 1970
Also Act 345, PA 1990

OTSEGO COUNTY MICHIGAN RECEIVED FOR RECORD
00 JAN 10 AM 10:11
EVELYN M. PRATT CLERK / REGISTER OF DEEDS

SECTION

For corners in

Form with fields for Otsego (County), Located In: Corwith Township, Corner Code # J-9, and sections 1-5 for Public Land Survey, Property Controlling, Miscellaneous, Lot No., and Private Claims.

Register of Deeds Stamp & File Number

I, James L. Schwandt, in a field survey on Jan. 19, 1999, do hereby state that under requirements of P.A. 74, Michigan P.A. of 1970, the corner points mentioned in lines 1 and 2 above were in conformance with regulations and rules therefore as required in the current manual of survey instructions of the United States Department of the Interior, Bureau of Land Management or by a decree of a Court of Law and/or that the corner points mentioned in lines 3, 4 and 5 above were in conformance with the rules of the Michigan Board of Land Surveyors or by a Decree of a Court of Law; established, re-established, monumented, recovered, found as expressed below:

NOTE: Not more than 4 corners, all in the same town and range, may be recorded on this certificate.

Grid table with columns A-M and rows 1-13, containing numbers 1-36 and a dot in cell J9.

A. Description of original monument and accessories and/or subsequent restoration:

J-9 T32N-R2W
G.L.O. John Mullett, June 22, 1850
Set Pine 1/4 Sec Post
Spruce Pine 6" N15°W, 42 links (27.72')
Spruce Pine 12" S34°E, 19 links (12.54')

James L. Schwandt #26466 1987 & 1989
Fnd O.C.M.
8" J. Pine S80E, 25.12'
7" J. Pine North 42.00'
6" J. Pine S60°W, 33.20'
5" J. Pine N85°W, 33.00'

James L. Schwandt #26466, 1991
Fnd O.C.M.
8" J. Pine S80°E, 25.12'
12" J. Pine N35°W, 21.79'
6" J. Pine S60°W, 33.20'
5" J. Pine N85°W, 33.00'

Carl I. Robinson #16390, 1980
Set O.C.M., Fnd 2" angle iron in corner
Set Spk 6" J. Pine, S80°E, 25.05'
Set Spk 4" J. Pine, S60°W, 33.32'
Set Spk 4" J. Pine, N85°W, 33.04'
Set Spk 6" J. Pine North 42.03'

B. Description of corner evidence found and/or method applied in restoring or reestablishing corner:


Found O.C.M. that fits G.L.O.
6" J. Pine, S80°E, 25.05', Fd stump
4" J. Pine, S60°W, 33.32', Fd stump
4" J. Pine, N85°W, 33.04', Fd spk under bark
8" J. Pine North 42.03', Fd spk under bark
12" J. Pine N35°W, 21.79', Fd nail & tag

OTSEGO COUNTY REMONUMENTATION

Approved by the County Survey Peer Group, pursuant to Act 345, PA 1990.

Dec. 29, 1999 Date

Signature of Chairman

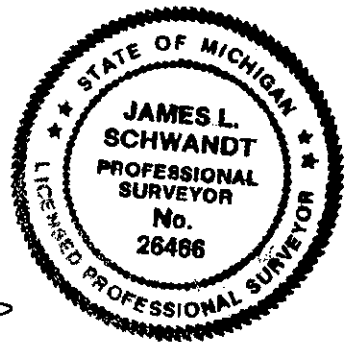

C. Description of monument for corner and accessories established to perpetuate locating the position of the corner:

Otsego County Monument left in corner and is accepted as the best available evidence of the position of the original corner.
8" J. Pine North 42.03'
14" J. Pine N35°W, 21.79'
6" J. Pine N85°W, 33.04'
4" J. Pine West 39.36'
12" J. Pine N35°W, 21.79'

Signed by James L. Schwandt
Surveyor's Michigan License No. 26466

Date 12-28-99