

SURVEY & REMONUMENTATION OTSEGO COUNTY REMONUMENTATION

MAY 28 1997

COMMISSION

LAND CORNER RECORDATION CERTIFICATE
Filing Requirement of Act 74, Mich. P.A. 1970
ALSO ACT 345, PA 1990

For corners in

Otsego (County)

Located In: Central Corwith Township Corner Code #

- 1. Public Land Survey T32NR2W J-11
2. Property Controlling in Section S T R
3. Miscellaneous Property in Sec. S T R

OTSEGO COUNTY MICHIGAN RECEIVED FOR RECORD 96 DEC 30 PM 2:16 EVELYN M. PRATT CLERK/REGISTER OF DEEDS

Register of Deeds Stamp & File Number

- 4. Lot No. Recorded Plat
5. Private Claims

I, James L. Schwandt, in a field survey on Nov. 22, 1996, do hereby certify that under requirements of P.A. 74, Michigan P.A. of 1970, the corner points mentioned in lines 1 and 2 above were in conformance with regulations and rules therefore as required in the current manual of survey instructions of the United States Department of the Interior, Bureau of Land Management or by a decree of a Court of Law and /or that the corner points mentioned in lines 3, 4 and 5 above were in conformance with the rules of the Michigan Board of Land Surveyors or by a Decree of a Court of Law, established, re-established, monumented, re-monumented, recovered, found as expressed below:

Grid table with columns A-M and rows 1-13. Cell (11, J) contains a black dot.

A. Description of original monument and accessories and/or subsequent restoration:


- J-11 T32N-R2W G.L.O. (2-228) William Burt, 1850 Set Pine 1/4 Post 10" W. Pine N68°W, 34 Links (22.44') 18" W. Pine S53°E, 54 Links (35.64') LCRC (2-153) C.I. Robinson, 1979 Fnd 1/2" Bar Replaced w/O.C.M. Spk in F.P. East, 4.20' Spk in F.P. West, 6.24' Spk in 14" W. Pine N10°W, 10.58' Spk in 16" W. Pine N45°E, 18.37'

B. Description of corner evidence found and/or method applied in restoring or reestablishing corner:

- Fnd O.C.M. Fnd Nail in F.P. East, 4.20' Fnd Nail in F.P. West, 8.24' Fnd Nail in 16" W. Pine N10°W, 9.40' Fnd Nail in 21" W. Pine N45°E, 17.85' Used in Several Surveys Dist Checked E& W w/G.L.O.

C. Description of monument for corner and accessories established to perpetuate locating the position of the corner:

- O.C.M., and is accepted as the best available evidence of the position of the original corner. Nail in F.P. East, 4.20' Nail in F.P. West, 8.24' Nail in 16" W. Pine N10°W, 9.40' Nail in 21" W. Pine N45°E, 17.85'

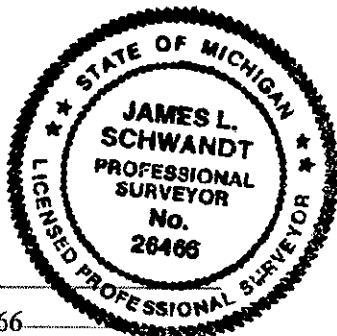

OTSEGO COUNTY REMONUMENTATION

Approved by the County Survey Peer Group, pursuant to Act 345, PA 1990.

Nov. 26, 1996 Date Chairman

Signed by James L. Schwandt Surveyor's Michigan License No. 26466

Date 12-20-96