

SURVEY & REMONUMENTATION OTSEGO COUNTY REMONUMENTATION

MAY 28 1997

COMMISSION

LAND CORNER RECORDATION CERTIFICATE
 Filing Requirement of Act 74, Mich. P.A. 1970
 ALSO ACT 345, PA 1990

For corners in

Otsego
 (County)

Located in: Corwith Township Corner Code #

- | | | |
|------------------------------------|--------------------------|------------|
| 1. Public Land Survey | T <u>32N</u> R <u>3W</u> | <u>C-4</u> |
| | T _____ R _____ | _____ |
| | T _____ R _____ | _____ |
| | T _____ R _____ | _____ |
| 2. Property Controlling in Section | S _____ T _____ | _____ |
| | S _____ T _____ | _____ |
| 3. Miscellaneous Property in Sec. | S _____ T _____ | _____ |
| | S _____ T _____ | _____ |

OTSEGO COUNTY MICHIGAN RECEIVED FOR RECORD

96 DEC 30 PM 2:16

EVELYN M. PRATT
 CLERK / REGISTER OF DEEDS

Register of Deeds Stamp & File Number

4. Lot No. _____, Recorded Plat _____
 5. Private Claims _____

I, **James L. Schwandt**, in a field survey on Nov. 21, 1996 do hereby certify that under requirements of P.A. 74, Michigan P.A. of 1970, the corner points mentioned in lines 1 and 2 above were in conformance with regulations and rules therefore as required in the current manual of survey instructions of the United States Department of the Interior, Bureau of Land Management or by a decree of a Court of Law and for that the corner points mentioned in lines 3, 4 and 5 above were in conformance with the rules of the Michigan Board of Land Surveyors or by a Decree of a Court of Law; established, re-established, monumented, re-monumented, recovered, found as expressed below:

	A	B	C	D	E	F	G	H	I	J	K	L	M
1													
2		6		5		4		3		2		1	
3													
4		7	●	8		9		10		11		12	
5													
6		18		17		16		15		14		13	
7													
8		19		20		21		22		23		24	
9													
10		30		29		28		27		26		25	
11													
12		31		32		33		34		35		36	
13													

A. Description of original monument and accessories and/or subsequent restoration:

C-4 T32N-R3W
 GLO (2-374)
 William Burt, 1850
 Set Sugar Qrt Sec Post
 Sugar 6" N45°W, 19 Links (12.54')
 Sugar 7" S64°E, 9 Links (5.94')

CSR (2-306,307)
 G.F. Delamater, 1940
 Fnd Both B's & P
 Elm 12" NW has been Cut

LCRC (2-140)
 P.E. Chenard, 1979
 Set O.C.M. @ Mid Point C-3 & C-5
 Fits Cherry Witness
 6" Cherry N79°E, 15.89'
 4" Maple S27°E, 64.49'
 11"
 Cherry S83°W, 32.90'

CSR (2-306,307)
 G.F. Delamater, 1932
 Est Midway In-Line
 Elm 12" N46°W, 42.1'
 Elm 6" S61°E, 41.1'


Elm 7" N62°E, 32.2'
 Cherry 5" S83°W, 32.3'
 1/2" Bar in Cor

B. Description of corner evidence found and/or method applied in restoring or reestablishing corner:

Fnd O.C.M.
 Fnd Tag #14200 in 9" Cherry S84°W, 33.09'
 Fnd Tag in 9" Cherry N78°E, 15.95'

C. Description of monument for corner and accessories established to perpetuate locating the position of the corner:

O.C.M. in corner, and is accepted as a careful and faithful reestablishment of the position of the original corner.
 Set Tag #41099 in 9" Cherry N78°E, 15.95'
 5" Maple S41°E, 29.83'
 6" Maple S83°W, 22.60'
 6" Elm N68°W, 20.22'

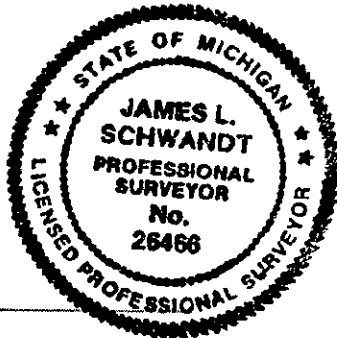

OTSEGO COUNTY REMONUMENTATION

Approved by the County Survey Peer Group, pursuant to Act 345, PA 1990.

Nov. 26, 1996 _____
 Date Chairman

Signed by James L. Schwandt
 Surveyor's Michigan License No. 26466

Date 12-20-96