

OTSEGO COUNTY REMONUMENTATION

MAY 28 1997

COMMISSION

LAND CORNER RECORDATION CERTIFICATE  
Filing Requirement of Act 74, Mich. P.A. 1970  
ALSO ACT 345, PA 1990

For corners in

Otsego  
(County)

Located In: W. Corwith Township Corner Code # C-5

- 1. Public Land Survey T32N R3W C-5  
T      R       
T      R       
T      R
- 2. Property Controlling in Section S      T      R       
S      T      R
- 3. Miscellaneous Property in Sec. S      T      R       
S      T      R

OTSEGO COUNTY MICHIGAN RECEIVED FOR RECORD

96 DEC 30 PM 2:16

EVELYN H. PRATT  
CLERK / REGISTER OF DEEDS

Register of Deeds Stamp & File Number

- 4. Lot No. \_\_\_\_\_, Recorded Plat \_\_\_\_\_
- 5. Private Claims \_\_\_\_\_

|    | A | B  | C | D  | E | F  | G | H  | I | J  | K | L  | M |
|----|---|----|---|----|---|----|---|----|---|----|---|----|---|
| 1  |   |    |   |    |   |    |   |    |   |    |   |    |   |
| 2  |   | 6  |   | 5  |   | 4  |   | 3  |   | 2  |   | 1  |   |
| 3  |   |    |   |    |   |    |   |    |   |    |   |    |   |
| 4  |   | 7  |   | 8  |   | 9  |   | 10 |   | 11 |   | 12 |   |
| 5  |   |    |   |    |   |    |   |    |   |    |   |    |   |
| 6  |   | 18 |   | 17 |   | 16 |   | 15 |   | 14 |   | 13 |   |
| 7  |   |    |   |    |   |    |   |    |   |    |   |    |   |
| 8  |   | 19 |   | 20 |   | 21 |   | 22 |   | 23 |   | 24 |   |
| 9  |   |    |   |    |   |    |   |    |   |    |   |    |   |
| 10 |   | 30 |   | 29 |   | 28 |   | 27 |   | 26 |   | 25 |   |
| 11 |   |    |   |    |   |    |   |    |   |    |   |    |   |
| 12 |   | 31 |   | 32 |   | 33 |   | 34 |   | 35 |   | 36 |   |
| 13 |   |    |   |    |   |    |   |    |   |    |   |    |   |

I, James L. Schwandt, in a field survey on Sept. 24, 1996, do hereby certify that under requirements of P.A. 74, Michigan P.A. of 1970, the corner points mentioned in lines 1 and 2 above were in conformance with regulations and rules therefore as required in the current manual of survey instructions of the United States Department of the Interior, Bureau of Land Management or by a decree of a Court of Law and /or that the corner points mentioned in lines 3, 4 and 5 above were in conformance with the rules of the Michigan Board of Land Surveyors or by a Decree of a Court of Law; established, re-established, monumented, re-monumented, recovered, found as expressed below:

A. Description of original monument and accessories and/or subsequent restoration:

C-5 T32N-R3W  
GLO William Burt, 1850 (374)  
Set Sugar Post  
Sugar 14" N69°W, 29 Links (19.14')  
Sugar 14" S47°E, 5 Links (3.3')

CSR (2-476)  
G.F. Delamater, 1932  
Fnd B's & P  
1/2" x 30" Bar in Cor  
Elm 4" S47 1/2°E, 63.0'  
Linn 6" S37 1/2°W, 53.5'

LCRC (2-140)  
P.E. Chenard, 1979  
Reconstructed Line Between  
C-3 & C-7 per GFD notes & Set O.C.M.  
6" Maple N58°E, 15.47'  
16" Elm S30°E, 37.42'  
6" Maple S73°E, 51.67'


B. Description of corner evidence found and/or method applied in restoring or reestablishing corner:

Fnd Broken O.C.M.  
Fnd 12" Maple N58°E, 15.47'  
Centerline of Road Intersection (Myrtle & Lewis) N80°W, 44.41'

C. Description of monument for corner and accessories established to perpetuate locating the position of the corner:

Replaced broken O.C.M. with new O.C.M., and is accepted as a careful & faithful perpetuation of the position of the original corner.

- Set Tag #41099 in 15" Poplar N47°E, 31.02'
- Set Tag #41099 in 6" Maple S46°E, 35.08'
- Set Tag #41099 in 8" Tri-Elm N65°W, 54.71'
- Nail in 12" Maple N58°E, 15.47'

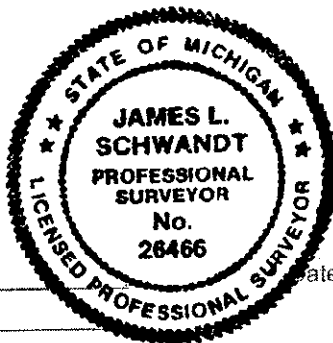

OTSEGO COUNTY REMONUMENTATION

Approved by the County Survey Peer Group, pursuant to Act 345, PA 1990.  
Nov. 26, 1996 \_\_\_\_\_  
Date Chairman

Signed by James L. Schwandt  
Surveyor's Michigan License No. 26466

Date 12-20-96