

SURVEY & REMONUMENTATION

OTSEGO COUNTY REMONUMENTATION

MAY 28 1997

COMMISSION

LAND CORNER RECORDATION CERTIFICATE
Filing Requirement of Act 74, Mich. P.A. 1970

For corners in

ALSO ACT 345, PA 1990

Otsego <small>(County)</small>	Located In:	Corner Code #
	W. CORWITH TOWNSHIP	H-7
1. Public Land Survey	T <u>32N</u> R <u>3W</u>	_____
	T _____ R _____	_____
	T _____ R _____	_____
	T _____ R _____	_____
2. Property Controlling in Section	S _____ T _____ R _____	_____
	S _____ T _____ R _____	_____
3. Miscellaneous Property in Sec.	S _____ T _____ R _____	_____
	S _____ T _____ R _____	_____

OTSEGO COUNTY
MICHIGAN
RECEIVED FOR RECORD

96 DEC 30 PM 2:16

EVELYN M. PRATT
CLERK / REGISTER OF DEEDS

Register of Deeds Stamp & File Number

4. Lot No. _____, Recorded Plat _____
5. Private Claims _____

I, James L. Schwandt, in a field survey on Nov. 21, 1996 do hereby certify that under requirements of P.A. 74, Michigan P.A. of 1970, the corner points mentioned in lines 1 and 2 above were in conformance with regulations and rules therefore as required in the current manual of survey instructions of the United States Department of the Interior, Bureau of Land Management or by a decree of a Court of Law and for that the corner points mentioned in lines 3, 4 and 5 above were in conformance with the rules of the Michigan Board of Land Surveyors or by a Decree of a Court of Law; established, re-established, monumented, re-monumented, recovered, found as expressed below:

	A	B	C	D	E	F	G	H	I	J	K	L	M
1													
2		6		5		4		3		2		1	
3													
4		7		8		9		10		11		12	
5													
6		18		17		16		15		14		13	
7								●					
8		19		20		21		22		23		24	
9													
10		30		29		28		27		26		25	
11													
12		31		32		33		34		35		36	
13													

A. Description of original monument and accessories and/or subsequent restoration:

H-7 T32N-R3W
G.L.O. (2-338)
William Burt, 1850
Set Sugar 1/4 Sec Post
Sugar 8" N27°W, 15 Links (9.90')
Sugar 10" S42°E, 29 Links (19.14')

CSR (2-269) G.F. Delamater, 1932
Found Old P. & 1/2" x 30" Bar in Cor
Cor of Old Cemetary Fence, S02°E, 26.5'

CSR (3-104)
MDOT per Thorsen, 1959
Maple 24" S60°E, 50.56'
T. Elm 24" N30°E, 58.69'

C.I. Robinson, 1984
Fnd 1/2" Bar Replaced with OCM
Spk 10" Maple, S72°W, 71.37'
MDOT Tag 34" Maple, S59°E, 50.48'
Ch Lk A.P., S06°W, 35.37'
Spk 19" Maple, N58°E, 57.53'


CSR (3-104)
G.F. Delamater, 1937
1/2" x 30" in Cor
Cemetary Fence Cor S02°E, 26.5'
Sugar 14" S63°E, 49.9'

B. Description of corner evidence found and/or method applied in restoring or reestablishing corner:

Fnd O.C.M.
Fd. DeLaMater's Maple w/MDOT tag
& Robinson's witness's

C. Description of monument for corner and accessories established to perpetuate locating the position of the corner:

O.C.M. in corner, and is a careful and faithful perpetuation of the position of the original corner.
MDOT Tag in 36" Maple S63°E, 50.52'
Tag in 27" Maple S59°W, 66.93'
24" Maple N56°E, 57.50'
Chain Link Fence Post S02°W, 35.45'

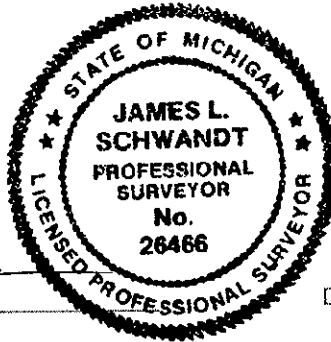

OTSEGO COUNTY REMONUMENTATION

Approved by the County Survey Peer
Group, pursuant to Act 345, PA 1990.
Nov. 26, 1996 _____
Date Chairman

Signed by James L. Schwandt
Surveyor's Michigan License No. 26466

Date 12-13-96