

SURVEY & REMONUMENTATION

OTSEGO COUNTY REMONUMENTATION

MAY 28 1997

COMMISSION

LAND CORNER RECORDATION CERTIFICATE

Filing Requirement of Act 74, Mich. P.A. 1970

ALSO ACT 345, PA 1990

For corners in

Otsego

(County)

Located In:

Corner Code #

W. CORWITH TOWNSHIP

1. Public Land Survey

T32N R3W

H-8

T R

T R

T R

2. Property Controlling in Section

S

T R

S

T R

3. Miscellaneous Property in Sec.

S

T R

S

T R

4. Lot No. , Recorded Plat

5. Private Claims

OTSEGO COUNTY MICHIGAN RECEIVED FOR RECORD

96 DEC 30 PM 2:16

EVELYN M. PRATT CLERK / REGISTER OF DEEDS

Register of Deeds Stamp & File Number

I, James L. Schwandt, in a field survey on Nov. 21, 1996 do hereby certify that under requirements of P.A. 74, Michigan P.A. of 1970, the corner points mentioned in lines 1 and 2 above were in conformance with regulations and rules therefore as required in the current manual of survey instructions of the United States Department of the Interior, Bureau of Land Management or by a decree of a Court of Law and for that the corner points mentioned in lines 3, 4 and 5 above were in conformance with the rules of the Michigan Board of Land Surveyors or by a Decree of a Court of Law; established, re-established, monumented, re-monumented, recovered, found as expressed below:

Grid table with columns A-M and rows 1-13. A dot is marked at the intersection of column H and row 8.

A. Description of original monument and accessories and/or subsequent restoration:

H-8 T32N-R3W LCRC 1-257
Not an original Govt Cor G.R. McKelvey, 1973
Fnd 1/2" Rerod used by M.D.S.H. at West Edge Pavement
36" Elm N73°W, 30.54'
15" Maple N18°W, 60.02'
10" R. Pine N31°E, 82.84'
1/2" Rerod N88°W, 33.05'

C.I. Robinson, 1984
Fnd 1/2" Rod Replaced w/O.C.M.
20" Map, N26°W, 46.45'
14" R. Pine, N30°E, 82.73'
1/2" Iron Rod, N88°W, 33.05'

B. Description of corner evidence found and/or method applied in restoring or reestablishing corner:

Fnd O.C.M. at West Edge Pavement
Fnd 24" Maple N18°W, 60.02'
Fnd 22" R. Pine N31°E, 82.50'
Fnd 1/2" Rod N88°W, 33.05'

C. Description of monument for corner and accessories established to perpetuate locating the position of the corner:


O.C.M. This position not established by original government surveyors. This monument is accepted as the best available evidence of the position of the corner.

Nail & Tag #19001 in 22" R. Pine N31°E, 82.50'
Nail in 9" Twin Maple S36°W, 50.38'
Nail in 22" Maple N27°W, 46.87'
1/2" Iron Rod N88°W, 33.05'

OTSEGO COUNTY REMONUMENTATION

Approved by the County Survey Peer Group, pursuant to Act 345, PA 1990.

Nov 26, 1996 Date Chairman

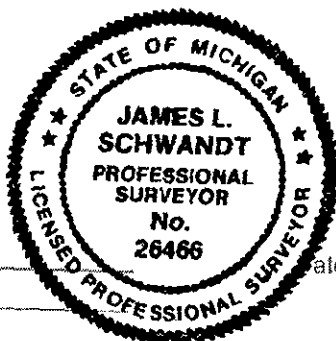

Signed by James L. Schwandt
Surveyor's Michigan License No. 26466

Date 12-13-96