

SURVEY & REMONUMENTATION

OTSEGO COUNTY REMONUMENTATION

MAY 28 1997

COMMISSION

LAND CORNER RECORDATION CERTIFICATE
Filing Requirement of Act 74, Mich. P.A. 1970

ALSO ACT 345, PA 1990

For corners in

Otsego

(County)

Located in: Corner Code #
W. CORWITH TOWNSHIP

- 1. Public Land Survey T32N R3W H-9
- T R
- T R
- T R
- 2. Property Controlling S T R
- in Section S T R
- 3. Miscellaneous S T R
- Property in Sec. S T R

OTSEGO COUNTY
MICHIGAN
RECEIVED FOR RECORD
96 DEC 30 PM 2:16
EVELYN M. PRATT
CLERK / REGISTER OF DEEDS

Register of Deeds Stamp & File Number

- 4. Lot No. _____, Recorded Plat _____
- 5. Private Claims _____

I, James L. Schwandt, in a field survey on Nov. 21, 1996, do hereby certify that under requirements of P.A. 74, Michigan P.A. of 1970, the corner points mentioned in lines 1 and 2 above were in conformance with regulations and rules therefore as required in the current manual of survey instructions of the United States Department of the Interior, Bureau of Land Management or by a decree of a Court of Law and for that the corner points mentioned in lines 3, 4 and 5 above were in conformance with the rules of the Michigan Board of Land Surveyors or by a Decree of a Court of Law; established, re-established, monumented, re-monumented, recovered, found as expressed below:

	A	B	C	D	E	F	G	H	I	J	K	L	M
1													
2		6		5		4		3		2		1	
3													
4		7		8		9		10		11		12	
5													
6		18		17		16		15		14		13	
7													
8		19		20		21		22		23		24	
9								●					
10		30		29		28		27		26		25	
11													
12		31		32		33		34		35		36	
13													

A. Description of original monument and accessories and/or subsequent restoration:


- H-9 T32N-R3W CSR (2-314) CSR (3-454) LCRC (2-39)
 - G.L.O. (2-349) GFD, 1925 MDOT Recorded by Thorsen, 1959 G.R. McKelvey, 1976
 - William Burt, 1850 Fnd Gas Pipe in Cor 1" Bar in Mon Box Fnd Mon Box; All Witnesses Gone
 - Set Beech 1/4 Sec Post SW Cor Store North, 40' P.P. N45°E, 41.97' Tag in U. Pole N45°W, 48.10'
 - Sugar 12" N10°E, 6 Links (3.96') NW Cor Gas Station S44°W, 80' P.P. N45°W, 45.70' Tag in U. Pole N45°E, 44.60'
 - Beech 8" S79W, 35 Links (23.1') Mon Box Placed in 1929 P.P. S53°W, 46.90' Tag in U. Pole S45°E, 46.57'
- CIR Set OCM (85) @ Mon Box Location

B. Description of corner evidence found and/or method applied in restoring or reestablishing corner:

- Fnd O.C.M.
- Fnd Tag in P.P. N45°W, 47.90'
- Fnd Tag in P.P. N45°E, 44.68'
- Fnd 40 p Nail in P.P. S28°E, 61.91'

C. Description of monument for corner and accessories established to perpetuate locating the position of the corner:

O.C.M. in corner, and is accepted as a careful and faithful reestablishment of the position of the original corner.
Tag in P.P. N45°W, 47.90'
Tag in P.P. N45°E, 44.68'
40 p Nail in P.P. S28°E, 61.91'
Set Tag #41099 in P.P. S49°W, 47.68'

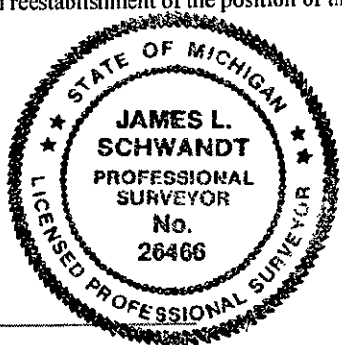

OTSEGO COUNTY REMONUMENTATION
Approved by the County Survey Peer Group, pursuant to Act 345, PA 1990.
Nov. 26, 1996 Date
Chairman

Signed by James L. Schwandt
Surveyor's Michigan License No. 26466

Date 11-26-96