

MAY 28 1997

COMMISSION

OTSEGO COUNTY REMONUMENTATION

LAND CORNER RECORDATION CERTIFICATE  
Filing Requirement of Act 74, Mich. P.A. 1970

For corners in

ALSO ACT 345, PA 1990

<u>Otsego</u> (County)	Located In:	Corner Code #
	<u>W. CORWITH TOWNSHIP</u>	<u>I-9</u>
1. Public Land Survey	<u>T32N R3W</u>	<u>I-9</u>
	T ___ R ___	_____
	T ___ R ___	_____
	T ___ R ___	_____
2. Property Controlling in Section	S ___ T ___ R ___	_____
	S ___ T ___ R ___	_____
3. Miscellaneous Property in Sec.	S ___ T ___ R ___	_____
	S ___ T ___ R ___	_____
4. Lot No. _____, Recorded Plat _____		
5. Private Claims _____		

OTSEGO COUNTY  
MICHIGAN  
RECEIVED FOR RECORD  
96 DEC 30 PM 2:16  
EVELYN M. PRATT  
CLERK / REGISTER OF DEEDS

Register of Deeds Stamp & File Number

I, James L. Schwandt, in a field survey on Nov. 21, 1996 do hereby certify that under requirements of P.A. 74, Michigan P.A. of 1970, the corner points mentioned in lines 1 and 2 above were in conformance with regulations and rules therefore as required in the current manual of survey instructions of the United States Department of the Interior, Bureau of Land Management or by a decree of a Court of Law and for that the corner points mentioned in lines 3, 4 and 5 above were in conformance with the rules of the Michigan Board of Land Surveyors or by a Decree of a Court of Law; established, re-established, monumented, re-monumented, recovered, found as expressed below:

A	B	C	D	E	F	G	H	I	J	K	L	M
1												
2	6		5		4		3		2		1	
3												
4	7		8		9		10		11		12	
5												
6	18		17		16		15		14		13	
7												
8	19		20		21		22		23		24	
9								●				
10	30		29		28		27		26		25	
11												
12	31		32		33		34		35		36	
13												

A. Description of original monument and accessories and/or subsequent restoration:

I-9 T32N-R3W  
G.L.O. (2-345)  
William Burt, 1850  
Sugar 20" S08°E, 19 Links (12.54')  
Sugar 10" N69°W, 15 Links (9.9')

CSR (2-314)  
G.F. Delamater 6-27-34  
Iron @ Cor, Fnd Sanborns B's & P  
Con Mon S46°W, 46.7'  
Con Mon S43°E, 46.7'

CIR Set O.C.M. per Wits in 1985

CSR (1-31)  
J.W. Sanborn, 1884  
Sugar 20" S56°W, 51 1/2 Links, (33.99')  
Hemlock 24" S78°W, 41 1/2 Links (27.39')

RS (198-23)  
Donald E. Marlett, 1975  
Fnd 1/2" Rerod  
P.P. S45°W, 43.35'  
T.P. S30°E, 41.0'  
36" Elm N50°E, 43.3'


LCRC (3-22)  
J.A. Porter, 1988  
Fnd O.C.M.  
Nail & Tag in F.P. NW, 53.44'  
Nail & Tag in P.P. NE, 57.05'  
Nail & Tag in P.P. SW, 43.35'  
Nail & Tag in P.P. SE, 40.95'

B. Description of corner evidence found and/or method applied in restoring or reestablishing corner:

Fnd O.C.M.  
Fnd. Tag #19003 in P.P. N23°E, 57.10'  
Fnd 60 p Nail in P.P. S54°E, 40.15'  
Fnd Nail in P.P. S45°W, 43.35'

C. Description of monument for corner and accessories established to perpetuate locating the position of the corner:

O.C.M. in corner, and is accepted as a careful & faithful perpetuation of the position of the original corner.  
Nail & Tag #19003 in P.P. N23°E, 57.10'  
P.P. S54°E, 40.15' Nail in P.P. S54°E, 40.15'  
Nail in P.P. S45°W, 43.35'  
Stop Sign Post N30°W, 52.00'

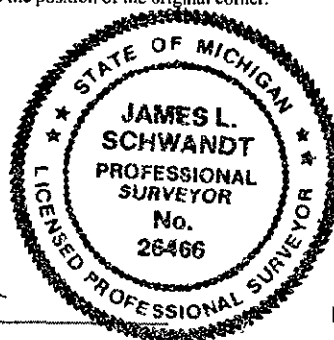

OTSEGO COUNTY REMONUMENTATION

Approved by the County Survey Peer Group, pursuant to Act 345, PA 1990.  
Nov. 26, 1996  
Date \_\_\_\_\_ Chairman \_\_\_\_\_

Signed by James L. Schwandt  
Surveyor's Michigan License No. 26466

Date 11-26-96