

# SURVEY & REMONUMENTATION

FEB 27 1998

## SECTION

### OTTAWA COUNTY REMONUMENTATION LAND CORNER RECORDATION CERTIFICATE Filing Requirement of Act 74, Mich. P.A. 1970

For corners in

OTTAWA (County)	Located In:	Corner Code #
1. Public Land Survey	T 5N R 13W T R T R T R	A-3 (NW cor Sec 7) Jamestown Twp
2. Property Controlling in Section	S T R S T R	
3. Miscellaneous Property in Sec.	S T R S T R	

4. Lot No. \_\_\_\_\_, Recorded Plat \_\_\_\_\_  
5. Private Claims \_\_\_\_\_

I, Randal J. Vugteveen, in a field survey on October 16, 1997 do hereby state that under requirements of P.A. 74, Michigan P.A. of 1970, the corner points mentioned in lines 1 and 2 above were in conformance with regulations and rules therefore as required in the current manual of survey instructions of the United States Department of the Interior, Bureau of Land Management or by a decree of a Court of Law and /or that the corner points mentioned in lines 3, 4 and 5 above were in conformance with the rules of the Michigan Board of Land Surveyors or by a Decree of a Court of Law; established, re-established, monumented, recovered, found as expressed below:

NOTE: Not more than 2 corners, all in the same town and range, may be recorded on this certificate.

	A	B	C	D	E	F	G	H	I	J	K	L	M
1													
2	6		5		4		3		2		1		
3													
4	7		8		9		10		11		12		
5													
6	18		17		16		15		14		13		
7													
8	19		20		21		22		23		24		
9													
10	30		29		28		27		26		25		
11													
12	31		32		33		34		35		36		
13													

RECORDED  
97 DEC -8 AM 11:42

*Randy*  
REGISTER OF DEEDS  
OTTAWA COUNTY, MI

Register of Deeds Stamp & File Number

#### A. Description of original monument and accessories and/or subsequent restoration:

A-3 Section corner common to Sections 6 and 7  
GLO (1831)  
Lucious Lyon (no monument specified)  
9" Elm S34°E 18 links  
6" Beech N22°E 36 links  
Post North 72 links

MSHD (1965) 3/4" pipe  
21" Maple S45°W 66.95'  
24" Maple S15°W 69.96'  
24" Cherry S85°E 70.61"  
Zeeland Twp corner N 49.55'

Ottawa County recorded survey  
Liber 4, Page 508 (1979)  
Centerline St. sign NW 45.06'  
Nail in W side Twin 10" Ash SSW 69.91'  
Nail in W side 20" Maple SW 42.50'

#### B. Description of corner evidence found and/or method applied in restoring or reestablishing corner:

A-3 Found capped iron

Found capped iron 0.99' W of range line  
Zeeland Twp corner AZ 0° 49.46'  
Center of 24" Maple AZ 249° 42.9'  
Centerline old road bed to East

Accepted position of capped iron as a careful perpetuation of the position of the original corner

Set 3/4"x24" solid bar with Ottawa County Remon cap in monument box on Range Line

PA 345 OTTAWA COUNTY  
PEER APPROVED 12/1/97


#### C. Description of monument for corner and accessories established to perpetuate locating the position of the corner:

A-3 3/4" X 24" solid bar with Ottawa County Remon cap in monument box on Range Line NOTE: (see sketch on back)

Zeeland Twp corner AZ 0° 49.46'  
Set Ottawa County Remon tag & nail in N side 12" Elm AZ 70° 34.04'  
Set Ottawa County Remon tag & nail in N side 24" Maple AZ 249° 42.94'  
Set Ottawa County tag & nail in N side 7" Maple AZ 105° 37.45'  
Set Ottawa County tag & nail in SW side 20" Maple AZ 322° 110.61'  
Capped iron at closing corner AZ 270° 0.99'  
Centerline Old Road Bed to E AZ 90° 0'  
Centerline N-S paved road AZ 90° 0'

Signed by Randal J. Vugteveen  
Surveyor's Michigan License No. 28429

Date Dec 1, 1997

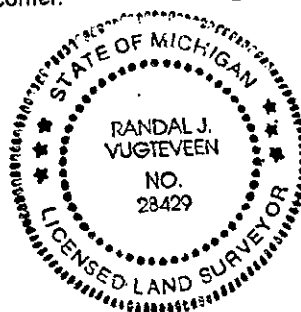

\$ 11.00 CORNER  
\$ 2.00 PHOTO