

SURVEY & REMONUMENTATION

FEB 27 1998

SECTION

Ottawa County Remonumentation
LAND CORNER RECORDATION CERTIFICATE
 Filing Requirement of Act 74, Mich. P.A. 1970

For corners in
Ottawa
 (County)

Located In: Corner Code #

- | | | |
|------------------------------------|--------------------------|----------------------|
| 1. Public Land Survey | T <u>5N</u> R <u>13W</u> | <u>A-4</u> |
| | T _____ R _____ | <u>JAMESTOWN TWP</u> |
| | T _____ R _____ | _____ |
| | T _____ R _____ | _____ |
| 2. Property Controlling in Section | S _____ T _____ R _____ | _____ |
| | S _____ T _____ R _____ | _____ |
| 3. Miscellaneous Property in Sec. | S _____ T _____ R _____ | _____ |
| | S _____ T _____ R _____ | _____ |

4. Lot No. _____, Recorded Plat _____
 5. Private Claims _____

I, Rodney D. Unema, in a field survey on November 26, 19 97, do hereby certify that under requirements of P.A. 74, Michigan P.A. of 1970, the corner points mentioned in lines 1 and 2 above were in conformance with regulations and rules therefore as required in the current manual of survey instructions of the United States Department of the Interior, Bureau of Land Management or by a decree of a Court of Law and/or that the corner points mentioned in lines 3, 4 and 5 above were in conformance with the rules of the Michigan Board of Land Surveyors or by a Decree of a Court of Law; established, re-established, monumented, re-monumented, recovered, found as expressed below:

NOTE: Not more than 4 corners, all in the same town and range, may be recorded on this certificate.

A. Description of original monument and accessories and/or subsequent restoration:

- | | |
|---|---|
| A-4 LCRC Liber 1, Page 685 (Oct. 9, 1972) | LCRC Liber 4, Page 331 (Sept. 24, 1982) |
| Found 1" Iron | Set Cast Iron Mon. |
| ¢ Stump N25°W 53.8' | R/W Marker NE 100.26' |
| 18" Basswood S25°E 60.2' | Street Sign SE 48.21' |
| 6" Tw W Cherry N70°E 45.92' | 6" Apple NE 81.24' |
| E 1/4 cor. sec. 12-5-14 N 45.87' | Zeeland Cor. N 45.81' |

B. Description of corner evidence found and/or method applied in restoring or reestablishing corner:

A-4 Found Cast Iron Mon.
 Found Cast Iron Mon (M-4; Zeeland Twp.) North 45.81'
 No other witnesses found as prev. recorded

Re-witnessed C.I.M. and replaced with Ottawa County Cap on 24" X 3/4" Steel Bar in Mon. Box upon completion of road construction.

PA. 345 OTTAWA COUNTY
 PEER APPROVED 12-1-97

[Handwritten Signature]


C. Description of monument for corner and accessories established to perpetuate locating the position of the corner:

- A-4 W 1/4 Cor., Sec. 7-5-13
 Standard Ottawa County Cap on 24" X 3/4" Steel Bar in Mon. Box
 O.C. Nail & Tag in S end 18" CMP N35°W 49.83'
 O.C. Nail & Tag in W side PP S50°W 40.25'
 O.C. Nail & Tag in S side 8" Apple N65°E 81.32'
 O.C. Nail & Tag in NW side 18" Oak N35°E 98.11'
 E 1/4 Cor. Sec. 12-5-14 O.C. Mon. N0°E 45.81'
 On & N-S BT Road
 On & gravel road to East



Signed by Rodney D. Unema Date Dec. 1, 1997

Surveyor's Michigan License No. 33987

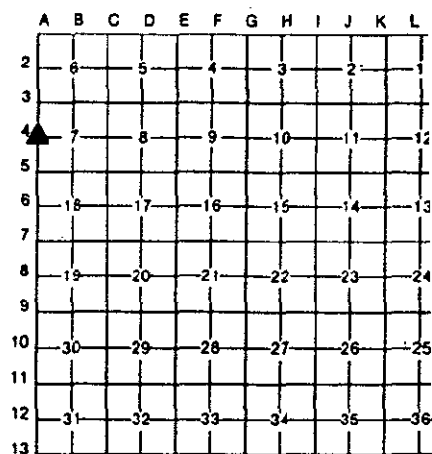

RECORDED
 97 DEC -8 AM 11:30
[Signature]
 REGISTER OF DEEDS
 OTTAWA COUNTY, MI
Register of Deeds Stamp & File Number