

**SURVEY &  
REMONUMENTATION**

APR 05 1996

**COMMISSION**

Ottawa County Remonumentation  
**LAND CORNER RECORDATION CERTIFICATE**  
Filing Requirement of Act 74, Mich. P.A. 1970

RECORDED

95 DEC 12 PM 4:51

*Phyllis Hallstrom*  
REGISTER OF DEEDS  
OTTAWA COUNTY, MI

For corners in  
Ottawa  
(County)

Located In: Corner Code #

- |                                    |            |                |
|------------------------------------|------------|----------------|
| 1. Public Land Survey              | T 5N R 13W | A-13 (SW, 31)  |
|                                    | T R        | Jamestown Twp. |
|                                    | T R        |                |
|                                    | T R        | Common corner  |
| 2. Property Controlling in Section | S T R      | w/ M-13        |
|                                    | S T R      | Zeeland Twp.   |
| 3. Miscellaneous Property in Sec.  | S T R      |                |
|                                    | S T R      |                |

*Seq. #1 pm*

Register of Deeds Stamp & File Number

4. Lot No. \_\_\_\_\_, Recorded Plat \_\_\_\_\_  
5. Private Claims \_\_\_\_\_

	A	B	C	D	E	F	G	H	I	J	K	L	M
2	6	5	4	3	2	1							
3													
4	7	8	9	10	11	12							
5													
6	18	17	16	15	14	13							
7													
8	19	20	21	22	23	24							
9													
10	30	29	28	27	26	25							
11													
12	31	32	33	34	35	36							
13													

I, John C. Bueche, in a field survey on November 30, 1995, do hereby certify that under requirements of P.A. 74, Michigan P.A. of 1970, the corner points mentioned in lines 1 and 2 above were in conformance with regulations and rules therefore as required in the current manual of survey instructions of the United States Department of the Interior, Bureau of Land Management or by a decree of a Court of Law and/or that the corner points mentioned in lines 3, 4 and 5 above were in conformance with the rules of the Michigan Board of Land Surveyors or by a Decree of a Court of Law; established, re-established, monumented, re-monumented, recovered, found as expressed below:

**NOTE: Not more than 4 corners, all in the same town and range, may be recorded on this certificate.**

A. Description of original monument and accessories and/or subsequent restoration:

A-13 GLO	LCRC L3-P31	LCRC L3-P70
Lucius Lyon, D.S.	Jan., 1976	April, 1976
Nov., 1831	T iron with cap	T iron in fence line
Existing cor.	GP NW 45.70'	East, 5' W of C/L
B. Ash 7 N 50 E 19	PP SW 48.86'	gravel rd.
B. Ash 6 S 56 W 11	GP SE 56.48'	GP N 40 W 45.75'
		PP S 40 W 48.55'
		Steel fe. post E 16.0'

B. Description of corner evidence found and/or method applied in restoring or reestablishing corner:

A-13 Found T iron down 0.9' in gravel rd.  
PK in NW side PP S 40 W 48.55'  
PK & Tag in SW side GP N 40 W 45.75'  
PK & Tag in N side GP SE 56.48'  
On old fence line E  
C/L gravel rd. N-S, East 5'±  
On South edge woods West (no rd.)

PEER APPROVED 12/11/95

*Madison D. ...*


And is accepted as a careful and faithful perpetuation of the position of the original corner.

C. Description of monument for corner and accessories established to perpetuate locating the position of the corner:

A-13 Replaced T iron with 3/4" x 24" Pin with Ottawa Co. Cap  
Set Nail & Ottawa Co. Remon. Tag in SE side PP S 40 W 48.90'  
Set Nail & Ottawa Co. Remon. Tag in SW side GP S 40 E 56.58'  
Set Nail & Ottawa Co. Remon. Tag in SE side PP N 60 E 51.96'  
Set Nail & Ottawa Co. Remon. Tag in S side GP N 40 W 45.74'  
C/L gravel rd. N-S, East 5'±, on old fence East, on South edge woods West

Signed by John C. Bueche  
John C. Bueche, P.S. 13027  
Surveyor's Michigan License No. \_\_\_\_\_

Date 12-6-95

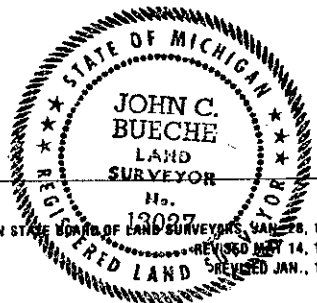

FORM APPROVED BY MICHIGAN STATE BOARD OF LAND SURVEYORS, JAN. 28, 1971  
REVISED MAY 14, 1975  
REVISED JAN., 1983