

**Ottawa County Remonumentation  
LAND CORNER RECORDATION CERTIFICATE  
Filing Requirement of Act 74, Mich. P.A. 1970**

For corners in

<u>Ottawa</u> <small>(County)</small>	Located in:	Corner Code #
1. Public Land Survey	T <u>5N</u> R <u>13W</u>	<u>A-13 (SW, 31)</u> <u>Jamestown Twp.</u>
	T _____ R _____	_____
	T _____ R _____	_____
	T _____ R _____	_____
2. Property Controlling in Section	S _____ T _____ R _____	<u>Seg. #2</u> <u>pm</u>
	S _____ T _____ R _____	_____
3. Miscellaneous Property in Sec.	S _____ T _____ R _____	_____
	S _____ T _____ R _____	_____
4. Lot No. _____, Recorded Plat _____		
5. Private Claims _____		

**RECORDED**

96 DEC 17 AM 10:41

*Phyllis Robinson*  
REGISTER OF DEEDS  
OTTAWA COUNTY, MI

Register of Deeds Stamp & File Number

I, John C. Bueche, in a field survey on November 7, 19 96, do hereby certify that under requirements of P.A. 74, Michigan P.A. of 1970, the corner points mentioned in lines 1 and 2 above were in conformance with regulations and rules therefore as required in the current manual of survey instructions of the United States Department of the Interior, Bureau of Land Management or by a decree of a Court of Law and/or that the corner points mentioned in lines 3, 4 and 5 above were in conformance with the rules of the Michigan Board of Land Surveyors or by a Decree of a Court of Law, established, re-established, monumented, re-monumented, recovered, found as expressed below:

**NOTE: Not more than 4 corners, all in the same town and range, may be recorded on this certificate.**

A	B	C	D	E	F	G	H	I	J	K	L	M
2	6	5	4	3	2							
3												
4	7	8	9	10	11	12						
5												
6	18	17	16	15	14	13						
7												
8	19	20	21	22	23	24						
9												
10	30	29	28	27	26	25						
11												
12	31	32	33	34	35	36						
13												

A. Description of original monument and accessories and/or subsequent restoration:

A-13 GLO Lucius Lyon, D.S. Nov., 1831 Existing cor.	LCRC L3-P31 Jan., 1976 T iron with cap GP NW 45.70' PP SW 48.86' GP SE 56.48'	LCRC L3-P70 April, 1976 T iron in fence line East, 5' W of C/L gravel rd. GP N 40° W 45.75' PP S 40° W 48.55' Steel fe. post E 16.0'
--	--	---

B. Description of corner evidence found and/or method applied in restoring or reestablishing corner:

A-13 Found T iron down 0.9' in gravel rd.  
PK in NW side PP S 40° W 48.55'  
PK & Tag in SW side GP N 40° W 45.75'  
PK & Tag in N side GP SE 56.48'  
On old fence line E  
C/L gravel rd. N-S, East 5'±  
On South edge woods West (no rd.)

OTTAWA COUNTY  
PEER APPROVED 11-11-96  
*J.C.B.*

And is accepted as a careful and faithful perpetuation of the position of the original corner.

C. Description of monument for corner and accessories established to perpetuate locating the position of the corner:


A-13 Replaced T iron with 3/4" x 24" Pin with Ottawa Co. Cap  
Set Nail & Ottawa Co. Remon. Tag in SE side PP S 40° W 48.90'  
Set Nail & Ottawa Co. Remon. Tag in SW side GP S 40° E 56.58'  
Set Nail & Ottawa Co. Remon. Tag in SE side PP N 60° E 51.96'  
Set Nail & Ottawa Co. Remon. Tag in S side GP N 40° W 45.74'  
C/L gravel rd. N-S, East 5'±, on old fence East, on South edge woods West

\$ 9.00 CORNER  
\$ 1.00 PHOTO

Signed by John C. Bueche  
John C. Bueche, P.S.

Date 11-7-96

Surveyor's Michigan License No. 13027

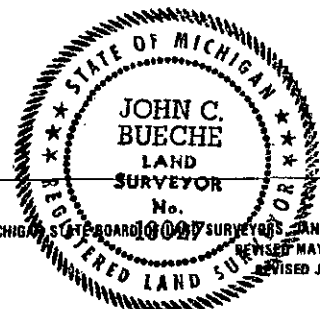

FORM APPROVED BY MICHIGAN STATE BOARD OF SURVEYORS JAN. 28, 1971  
REVISED MAY 14, 1975  
REVISED JAN., 1983