

SURVEY & REMONUMENTATION

DEC 01 1998

**Ottawa County Remonumentation
LAND CORNER RECORDATION CERTIFICATE
Filing Requirement of Act 74, Mich. P.A. 1970**

SECTION

For corners in
Ottawa
(County)

Located In:	Corner Code #
T <u>5N</u> R <u>13W</u>	<u>B-13 (S$\frac{1}{2}$, 31)</u>
T _____ R _____	<u>Jamestown Twp.</u>
T _____ R _____	_____
T _____ R _____	_____
T _____ R _____	_____
S _____ T _____ R _____	_____
S _____ T _____ R _____	_____
S _____ T _____ R _____	_____
S _____ T _____ R _____	_____

RECORDED
98 MAR 16 PM 12:37

Sam H. Miller
REGISTER OF DEEDS
OTTAWA COUNTY, MI

Register of Deeds Stamp & File Number

4. Lot No. _____, Recorded Plat _____
5. Private Claims _____

I, John C. Bueche, in a field survey on April 4, 1997, do hereby certify that under requirements of P.A. 74, Michigan P.A. of 1970, the corner points mentioned in lines 1 and 2 above were in conformance with regulations and rules therefore as required in the current manual of survey instructions of the United States Department of the Interior, Bureau of Land Management or by a decree of a Court of Law and/or that the corner points mentioned in lines 3, 4 and 5 above were in conformance with the rules of the Michigan Board of Land Surveyors or by a Decree of a Court of Law; established, re-established, monumented, re-monumented, recovered, found as expressed below:

A	B	C	D	E	F	G	H	I	J	K	L	I
2	6	5	4	3	2	1						
3												
4	7	8	9	10	11	12						
5												
6	18	17	16	15	14	13						
7												
8	19	20	21	22	23	24						
9												
10	30	29	28	27	26	25						
11												
12	31	32	33	34	35	36						
13												

NOTE: Not more than 4 corners, all in the same town and range, may be recorded on this certificate.

A. Description of original monument and accessories and/or subsequent restoration:

B-13 GLO, 1831 Lucius Lyon, DS Set H.M.P. Beech 4 N 55 E 22 Beech N 67 W 61 GLO from N 1/4 to NW cor. 6 42.37' (2796.42')	Jonker Survey, 1994 1/2" rerod N 1/4 6, 4-13 S 1/4 31, 5-13, West, 34.80'	L4, P600, 601, 602 Ottawa Co. CP Co. Survey, Feb., 1980
--	---	--

PA. 345 OTTAWA COUNTY
PEER APPROVED 4/21/97
John C. Bueche


B. Description of corner evidence found and/or method applied in restoring or reestablishing corner:

B-13 Found 1/2" rerod on C/L gravel road North extended South
On Fence & brush row East
On Power line (poles) E & W
N 1/4 cor. Sec. 6, 4-13 East 34.73'
Meas. West 2829.62 to SW cor. 31; CP Co. 2830.97 (GLO 2796.42')
Meas. East 2628.18 to SE cor. 31; CP Co. 2628.09 (GLO 2640.00')

And is accepted as a careful and faithful perpetuation of the position of the original corner.

C. Description of monument for corner and accessories established to perpetuate locating the position of the corner:

B-13 Replaced 1/2" rerod with Ottawa Co. Mon. (3/4" x 24" Pin with Alum. Cap)
Nail & Ottawa Co. Remon. Tag in N side PP N 89° E 45.83'
NW cor. metal shed S 62° E 84.02'
SW cor. metal shed S 34° E 144.53'
SE cor. metal shed S 40° W 71.78'
NE cor. metal shed S 57° W 55.91'
Allegan Co. Mon. N 1/4 6, 4-13 East 34.73'
On C/L gravel road North extend South
On fence & brush row East; on Power line E & W (not towers)
C/L Towers E-W, North 275'±

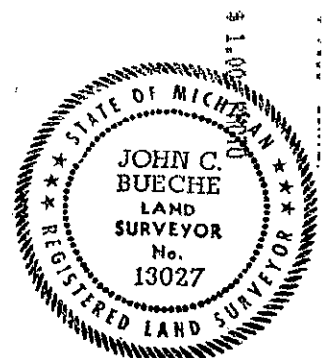

Signed by John C. Bueche Date 5-29-97
John C. Bueche, P.S. 13027
Surveyor's Michigan License No. _____