

SURVEY & REMONUMENTATION

FEB 27 1998

OTTAWA COUNTY REMONUMENTATION

LAND CORNER RECORDATION CERTIFICATE
Filing Requirement of Act 74, Mich. P.A. 1970

RECORDED

97 OCT 30 AM 11:00

For corners in **SECTION**


<u>Ottawa</u> (County)	Located In: Jamestown Twp.	Corner Code #:
1. Public Land Survey	T <u>5N</u> R <u>13W</u>	<u>C-2</u>
	T _____ R _____	<u>W 1/4, Sec. 5</u>
	T _____ R _____	_____
	T _____ R _____	_____
2. Property Controlling in Section	S _____ T _____ R _____	_____
	S _____ T _____ R _____	_____
3. Miscellaneous Property in Sec.	S _____ T _____ R _____	_____
	S _____ T _____ R _____	_____

Debra Gant

Register of Deeds
Ottawa County, MI

Register of Deeds Stamp & File Number

4. Lot No. _____, Recorded Plat _____
5. Private Claims _____

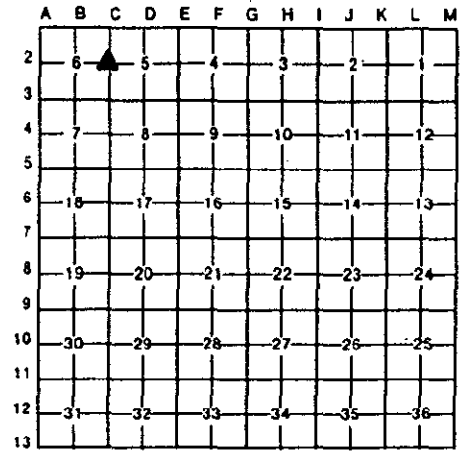

I, Rodney D. Unema, in a field survey on August 11, 19 97, do hereby certify that under requirements of P.A. 74, Michigan P.A. of 1970, the corner points mentioned in lines 1 and 2 above were in conformance with regulations and rules therefore as required in the current manual of survey instructions of the United States Department of the Interior, Bureau of Land Management or by a decree of a Court of Law and/or that the corner points mentioned in lines 3, 4 and 5 above were in conformance with the rules of the Michigan Board of Land Surveyors or by a Decree of a Court of Law; established, re-established, monumented, re-monumented, recovered, found as expressed below:

NOTE: Not more than 4 corners, all in the same town and range, may be recorded on this certificate.

A. Description of original monument and accessories and/or subsequent restoration:

C-2 1/4 Cor. Common to Secs. 5 & 6	LCRC Lib. 1, Pg. 303 (4-7-72)	LCRC Lib. 6, Pg. 22 (12-22-8)
Dec. 1831, Orig. Gov't.	Fnd 3/4" Steel Bar	Found Re-rod
Cor. set by Sylvester Sibley	Face of sign post W-NW 27.9'	PK in S sde Serv. Pole
Set H.W.P.	Face of St. sign post SE 22.13'	S70°E 40.48'
18" Beech S38°E 20 links	Nail in sde of New P.Pole SW 86.59'	Nail in S sde tree
18" Maple N39°W 28 links	Nail in side of new P.Pole E-SE 40.57'	N35°E 60.37'
		PK in E sde P.Pole S45°W
		86.74'
		PK in B.T. S 62.42'

B. Description of corner evidence found and/or method applied in restoring or reestablishing corner:

P.A. 345 OTTAWA COUNTY

C-2 1/4 Cor.
Found Mag. Nail in B.T. @ Intersection of 40th & Ransom
Found PK in S. side Service Pole S70°E 40.42'
Found PK in E side P. Pole S48°W 85.68'
Found Nail in SE side of 6" Ash N37°E 60.49'
φ Street Sign 30.13'

PEER APPROVED

9-15-97
[Signature]

Accepted as a careful perpetuation of the position of the original corner, and replaced M.A.G. Nail with standard Otta. Co. Cap on 3/4 X 24" Iron Bar in new Mon. Box.

C. Description of monument for corner and accessories established to perpetuate locating the position of the corner:

C-2 1/4 Corner between Sections 5 and 6
Standard Otta. Co. Cap on 3/4" X 24" Iron Bar in Mon. Box
On φ of N-S B.T. Road (40th)
Set Nail & O.C. Tag in W side 6" Ash N37°E 60.52'
Set Nail & O.C. Tag in S side Service Pole S70°E 40.40'
Set Nail & O.C. Tag in E side P. Pole S48°W 85.49'
Top φ of Hydrant N63°W 82.80'



Signed by *Rodney D. Unema* Date August 15, 1997
Surveyor's Michigan License No. 33987