

SURVEY & REMONUMENTATION

APR 24 1995

COMMISSION

OTTAWA COUNTY REMONUMENTATION

LAND CORNER RECORDATION CERTIFICATE

Filing Requirement of Act 74, Mich. P.A. 1970

RECORDED

94 DEC 15 AM 11:51

Deborah S. Sibley
REGISTER OF DEEDS
OTTAWA COUNTY, MI


For corners in

<u>Ottawa</u> (County)	Located In: Jamestown Township	Corner Code #
1. Public Land Survey	T 5N R 13W	C-3
	T _____ R _____	_____
	T _____ R _____	_____
	T _____ R _____	_____
2. Property Controlling in Section	S _____ T _____ R _____	_____
	S _____ T _____ R _____	_____
3. Miscellaneous Property in Sec.	S _____ T _____ R _____	_____
	S _____ T _____ R _____	_____

Register of Deeds Stamp & File Number

4. Lot No. _____, Recorded Plat _____
5. Private Claims _____

I, Rodney D. Unema, in a field survey on Dec. 7, 19 94, do hereby certify that under requirements of P.A. 74, Michigan P.A. of 1970, the corner points mentioned in lines 1 and 2 above were in conformance with regulations and rules therefore as required in the current manual of survey instructions of the United States Department of the Interior, Bureau of Land Management or by a decree of a Court of Law and/or that the corner points mentioned in lines 3, 4 and 5 above were in conformance with the rules of the Michigan Board of Land Surveyors or by a Decree of a Court of Law; established, re-established, monumented, re-monumented, recovered, found as expressed below:

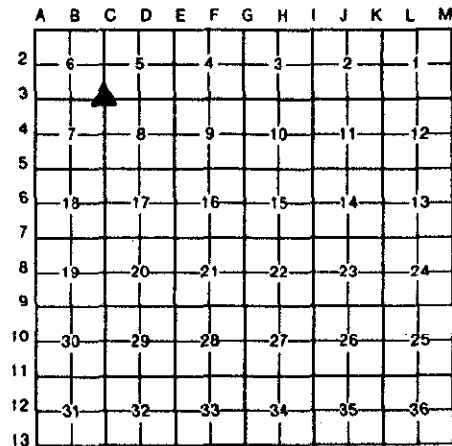

CONTINUED OVER--

NOTE: Not more than 4 corners, all in the same town and range, may be recorded on this certificate.

A. Description of original monument and accessories and/or subsequent restoration:

C-3 Corner common to Sections 5, 6, 7 and 8
Original gov't corner set in L.C.R.C. Liber 1, Pg. 303
Dec. 1831 by Sylvester Sibley April 7, 1972
Set Post Found 3/4" iron pipe
Beech 24" N84°E 25 links MSHD tag in T.Pole NE 49.32'
Beech 6" S80°W 18 links MSHD tag in fe. post WSW 34.35'
Street sign SE 39.55'
T.Pole SSE 103.81'

L.C.R.C. Liber 2, Pg. 577
Sept. 20, 1974
Found 1" iron bar
T.Pole NE 54.42'
C/L st. sign SE 39.61'
T.Pole SE 106.63'
P.P. NW 105.09'

B. Description of corner evidence found and/or method applied in restoring or reestablishing corner:


C-3 Found C.I.M. in Mon. Box in B.T.
Found PK nail in S'ly sde T.Pole N38°E 54.90'
Found nail & tag in S'ly sde P.Pole N21°W 104.97'
Found PK nail in W'ly sde T.Pole S17°E 106.92'
at intersection of Quincy St. and 40th Ave.

PA. 345 OTTAWA COUNTY
PEER APPROVED 12/12/94
Rodney D. Unema

Accepted as a careful perpetuation of the position of the original corner.

C. Description of monument for corner and accessories established to perpetuate locating the position of the corner:

C-3 Corner common to Sections 5, 6, 7 and 8
Cast Iron Mon. in Mon. Box at intersection of Quincy St. and 40th Ave.
Set O.C. nail & tag in W'ly sde of T.Pole S17°E 106.92'
Set O.C. nail & tag in E'ly sde of P.Pole N21°W 105.35'
Set O.C. nail & tag in S'ly sde of T.Pole N38°E 54.90'
Set O.C. nail & tag in S'ly sde of 12" Poplar N66°E 96.82'
Physical C/L "X" is 2.0' North and 2.0' East

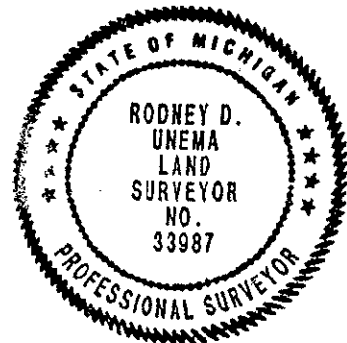

Signed by Rodney D. Unema
Surveyor's Michigan License No. 33987

Date Dec. 12, 1994

L.C.R.C. Liber 5, Pg. 259
Aug. 28, 1986
T.P. NE 54.90'
T.P. SE 107.0'
P.P. NW 105.09'
14" Elm WNW 74.82'
14" Elm SSW 102.72'

1230
OWNER
DATE #
1986