

**SURVEY &  
REMONUMENTATION**

APR 24 1995

**COMMISSION**

OTTAWA COUNTY REMONUMENTATION  
**LAND CORNER RECORDATION CERTIFICATE**  
Filing Requirement of Act 74, Mich. P.A. 1970

RECORDED

94 DEC 15 AM 11:51

For corners in  
Ottawa  
(County)

Located In:  
Jamestown Township

Corner Code #

1. Public Land Survey	T	5N	R	13W	C-4
	T		R		
	T		R		
	T		R		
2. Property Controlling in Section	S		T	R	
	S		T	R	
3. Miscellaneous Property in Sec.	S		T	R	
	S		T	R	

*Royella Ballman*  
REGISTER OF DEEDS  
OTTAWA COUNTY, MI

Register of Deeds Stamp & File Number

4. Lot No. \_\_\_\_\_, Recorded Plat \_\_\_\_\_  
5. Private Claims \_\_\_\_\_

I, Rodney D. Unema, in a field survey on Dec. 7, 19 94, do hereby certify that under requirements of P.A. 74, Michigan P.A. of 1970, the corner points mentioned in lines 1 and 2 above were in conformance with regulations and rules therefore as required in the current manual of survey instructions of the United States Department of the Interior, Bureau of Land Management or by a decree of a Court of Law and/or that the corner points mentioned in lines 3, 4 and 5 above were in conformance with the rules of the Michigan Board of Land Surveyors or by a Decree of a Court of Law; established, re-established, monumented, re-monumented, recovered, found as expressed below:

**NOTE: Not more than 4 corners, all in the same town and range, may be recorded on this certificate.**

A	B	C	D	E	F	G	H	I	J	K	L	M
2	6	5	4	3	2	1						
3												
4	7	8	9	10	11	12						
5												
6	18	17	16	15	14	13						
7												
8	19	20	21	22	23	24						
9												
10	30	29	28	27	26	25						
11												
12	31	32	33	34	35	36						
13												

**A. Description of original monument and accessories and/or subsequent restoration:**

C-4 1/4 Corner between Sections 7 and 8  
Original gov't corner set in L.C.R.C. Liber 2, Pg. 293  
Dec. 1831 by Sylvester Sibley Aug. 28, 1973  
Set H.W.P. 1/2" iron rod (found)  
Beech 10" N24°E 21 links MSHD tag sde TP NE 54.88'  
Beech 6" S17°W 33 links MSHD tag E sde PP NW 60.12'  
Ctr. st. sign SE 42.04'

L.C.R.C. Liber 2, Pg. 555  
Sept. 9, 1974  
1" iron rod (found)  
T.Pole (MSHD nail & tag on NE sde) NW 60.14'  
T.Pole (MSHD nail & tag on SE sde) ENE 54.87'  
PK in W'ly sde T.Pole NNE 64.23'  
PK in W'ly sde P.Pole SSE 147.98'

**B. Description of corner evidence found and/or method applied in restoring or reestablishing corner:**


C-4 Found C.I.M. in Mon. Box in B.T. at C/L "X" of 40th and Greenly  
Found PK in W sde of P and T Pole N30°E 64.32'  
Found PK in W sde of P.Pole S13°E 147.64'  
Found nail & tag in NE sde of P.Pole N48°W 60.18'

Accepted as a careful perpetuation of the position of the original corner.

**PA. 345 OTTAWA COUNTY**  
**PEER APPROVED** 12/12/94  
*Rodney D. Unema*

**C. Description of monument for corner and accessories established to perpetuate localizing the position of the corner:**

C-4 1/4 Corner between Sections 7 and 8  
Cast Iron Mon. in Mon. Box at intersection of Greenly St. and 40th Ave.  
Set O.C. nail & tag in W sde of P and T Pole N30°E 64.32'  
Set O.C. nail & tag in W sde of P.Pole S13°E 147.64'  
Set O.C. nail & tag in E sde of P.Pole S16°W 155.10'  
Set O.C. nail & tag in NE sde of P.Pole N48°W 60.18'  
C/L "X" of 40th Ave. and Greenly St. 0' North and 0' East

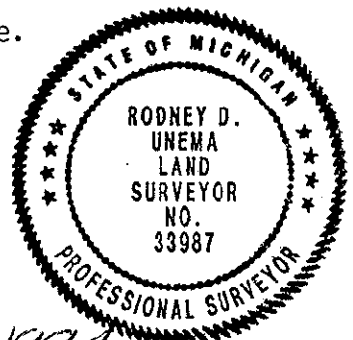

Signed by Rodney D. Unema  
Surveyor's Michigan License No. 33987

Date DEC. 12, 1994

FORM APPROVED BY MICHIGAN STATE BOARD OF LAND SURVEYORS, JAN. 28, 1971  
REVISED MAY 14, 1974  
REVISED JAN., 1982

L.C.R.C. Liber 2, Pg. 577  
Sept. 20, 1974  
Found 3/4" iron bar  
T.Pole NE 54.90'  
PP NE 64.27'  
PP NW 60.15'  
C/L st. sign SE 42.12'

L.C.R.C. Liber 5, Pg. 259  
Aug. 28, 1986  
Set C.I.M.  
T.P. NW 60.14'  
PK in T.P. NNE 64.35'  
PK in P.P. SSE 147.70'

CONF #  
CORNER  
CONF #  
1986