

SURVEY & REMONUMENTATION

APR 24 1995

COMMISSION

OTTAWA COUNTY REMONUMENTATION
LAND CORNER RECORDATION CERTIFICATE
Filing Requirement of Act 74, Mich. P.A. 1970

RECORDED

94 DEC 15 AM 11:45

Phyllis Karlsson
REGISTER OF DEEDS
OTTAWA COUNTY, MI

For corners in
Ottawa
(County)

Located In: Corner Code #

Jamestown Township

1. Public Land Survey		T <u>5N</u>	R <u>13W</u>		<u>C-6</u>
		T _____	R _____		_____
		T _____	R _____		_____
		T _____	R _____		_____
2. Property Controlling in Section	S _____	T _____	R _____		_____
	S _____	T _____	R _____		_____
3. Miscellaneous Property in Sec.	S _____	T _____	R _____		_____
	S _____	T _____	R _____		_____

Register of Deeds Stamp & File Number

4. Lot No. _____, Recorded Plat _____
5. Private Claims _____

I, Rodney D. Unema, in a field survey on Dec. 8, 19 94, do hereby certify that under requirements of P.A. 74, Michigan P.A. of 1970, the corner points mentioned in lines 1 and 2 above were in conformance with regulations and rules therefore as required in the current manual of survey instructions of the United States Department of the Interior, Bureau of Land Management or by a decree of a Court of Law and/or that the corner points mentioned in lines 3, 4 and 5 above were in conformance with the rules of the Michigan Board of Land Surveyors or by a Decree of a Court of Law; established, re-established, monumented, re-monumented, recovered, found as expressed below:

NOTE: Not more than 4 corners, all in the same town and range, may be recorded on this certificate.

	A	B	C	D	E	F	G	H	I	J	K	L	M
2	6	5	4	3	2	1							
3													
4	7	8	9	10	11	12							
5													
6	18	17	16	15	14	13							
7													
8	19	20	21	22	23	24							
9													
10	30	29	28	27	26	25							
11													
12	31	32	33	34	35	36							
13													

A. Description of original monument and accessories and/or subsequent restoration:

C-6 1/4 Corner between Sections 17 and 18	L.C.R.C. Liber 2, Pg. 773	L.C.R.C. Liber 5, Pg. 260
Original gov't corner set in	May 5, 1975	Aug. 28, 1986
Dec. 1831 by Sylvester Sibley	Found RR spike	Set C.I.M.
Set H.W.P.	P.Pole NE 33.56'	PP NE 34.18'
Beech 16" N46°E 27 links	St. sign SE 25.70'	St. sign SE 25.70'
Beech 14" N84°W 29 links	8" Willow SE 60.89'	S'yly sde of backstop SW 50.05'
	20" Willow SE 68.33'	12" Elm NNE 93.30'

B. Description of corner evidence found and/or method applied in restoring or reestablishing corner:

C-6 Found C.I.M. and Mon. Box in N bound lane of N-S BT Road at intersection 40th and Felch
 Found PK in S'yly sde P.Pole N57°E 34.28'
 Found S end of pole to backstop S45°W 49.92'
 Found leaning st. sign S42°E 31.28'


Accepted as a careful perpetuation of the position of the original corner.

PA. 345 OTTAWA COUNTY

PEER APPROVED 12/12/94

C. Description of monument for corner and accessories established to perpetuate locating the position of the corner:

C-6 1/4 Corner between Sections 17 and 18
 Cast Iron Mon. in Mon. Box at intersection of 40th Ave. and Felch St.
 Set O.C. nail & tag in S'yly sde of P.Pole N57°E 34.28'
 Set O.C. nail & tag in N'yly sde of 10" Elm S74°W 34.85'
 Set O.C. nail & tag in N'yly sde of 15" Wild Cherry S85°E 182.98'
 Set O.C. nail & tag in W'yly sde of P.Pole wires S06°E 266.20'
 NW cor of brick house S31°W 233.71'
 Found base of S end backstop pole S45°W 49.92'
 Physical C/L "X" of 40th and Felch is 3.5' West and 3.5' South

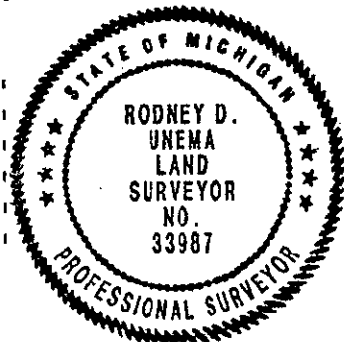

Signed by Rodney D. Unema
 Surveyor's Michigan License No. 33987

Date DEC. 12, 1994