

SURVEY & REMONUMENTATION

APR 24 1995

COMMISSION

OTTAWA COUNTY REMONUMENTATION
LAND CORNER RECORDATION CERTIFICATE
 Filing Requirement of Act 74, Mich. P.A. 1970

RECORDED

94 DEC 15 AM 11:51

For corners in
Ottawa
(County)


	Located In:	Corner Code #
	Jamestown Township	
1. Public Land Survey	T <u>5N</u> R <u>13W</u>	<u>C-8</u>
	T _____ R _____	_____
	T _____ R _____	_____
	T _____ R _____	_____
2. Property Controlling in Section	S _____ T _____ R _____	_____
	S _____ T _____ R _____	_____
3. Miscellaneous Property in Sec.	S _____ T _____ R _____	_____
	S _____ T _____ R _____	_____

Phyllis Hallman
 REGISTER OF DEEDS
 OTTAWA COUNTY, MI

Register of Deeds Stamp & File Number

4. Lot No. _____, Recorded Plat _____
 5. Private Claims _____

I, Rodney D. Unema, in a field survey on Dec. 8, 1994, do hereby certify that under requirements of P.A. 74, Michigan P.A. of 1970, the corner points mentioned in lines 1 and 2 above were in conformance with regulations and rules therefore as required in the current manual of survey instructions of the United States Department of the Interior, Bureau of Land Management or by a decree of a Court of Law and/or that the corner points mentioned in lines 3, 4 and 5 above were in conformance with the rules of the Michigan Board of Land Surveyors or by a Decree of a Court of Law; established, re-established, monumented, re-monumented, recovered, found as expressed below:

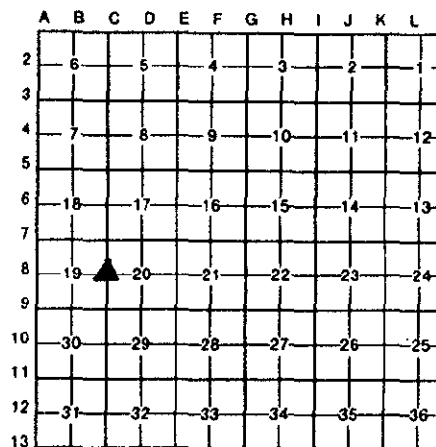

NOTE: Not more than 4 corners, all in the same town and range, may be recorded on this certificate.

A. Description of original monument and accessories and/or subsequent restoration:

C-8 1/4 Corner between Sections 19 and 20		
Original gov't corner set in	L.C.R.C. Liber 2, Pg. 33	L.C.R.C. Liber 3, Pg. 142
Dec. 1831 by Sylvester Sibley	Feb. 16, 1973	Jan. 3, 1977
Set H.W.P.	Found 1" sq. steel bar	Found RR spike
Beech 16" N49°E 27 links	P.Pole ESE 94.06'	Spike in sde 16" Maple NNE 111.8'
Beech 14" N84°W 19 links	C/L st. sign W 22.75'	Spike in sde 36" Maple W 83.62'
	T.Pole NW 62.26'	PK in sde P.Pole ESE 94.63'

CONTINUED OVER--

B. Description of corner evidence found and/or method applied in restoring or reestablishing corner:

C-8 Found C.I.M. in Box in B.T. road 4.5' East of C/L "X" 40th Ave. and Gordon St.	
C/L 36" Maple	N85°W 83.32'
Found lg. spike in W'ly sde of 20" Maple	N20°E 111.25'
Found PK in N sde P.Pole	S66°E 94.70'


Accepted as a careful perpetuation of the position of the original corner.

P.A. 345 OTTAWA COUNTY
PEER APPROVED

12/12/94
Rodney D. Unema

C. Description of monument for corner and accessories established to perpetuate locating the position of the corner:

C-8 1/4 Corner between Sections 19 and 20	
Cast Iron Mon. in Mon. Box at intersection of 40th Ave. and Gordon St.	
Set O.C. nail & tag in W'ly sde 20" Maple	N20°E 111.25'
Set O.C. nail & tag in S'ly sde 36" Maple	N85°W 83.32'
Set O.C. nail & tag in N'ly sde P.Pole	S66°E 94.70'
Set O.C. nail & tag in SE'ly sde tr. 10" Poplar	S63°W 122.89'
C/L "X" of BT roads	West 4.5'

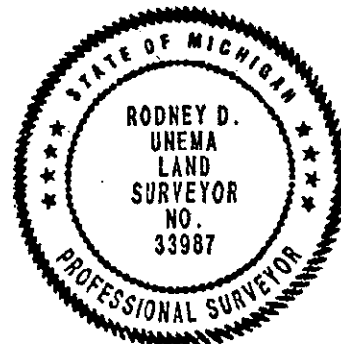

Signed by Rodney D. Unema
 Surveyor's Michigan License No. 33987

Date DEC. 12, 1994

L.C.R.C. Liber 5, Pg. 260
Aug. 28, 1986
Set C.I.M.
36" Maple W 83.62'
16" Maple NNE 111.80'
PP ESE 94.72'

CONC #
CORNER
NNE #
W 3000
1986