

SURVEY & REMONUMENTATION

OTTAWA COUNTY REMONUMENTATION

DEC 16 1996

LAND CORNER RECORDATION CERTIFICATE
Filing Requirement of Act 74, Mich. P.A. 1970

For corners in **COMMISSION**

Ottawa (County)	Located In:	Corner Code #
	Jamestown Twp. 5N 13W	C-11, SE cor.
1. Public Land Survey	T ___ R ___ T ___ R ___ T ___ R ___ T ___ R ___	Sec. 30
2. Property Controlling in Section	S ___ T ___ R ___ S ___ T ___ R ___	
3. Miscellaneous Property in Sec.	S ___ T ___ R ___ S ___ T ___ R ___	

RECORDED


96 NOV 14 AM 11:21

Royella Robinson
REGISTER OF DEEDS
OTTAWA COUNTY, MI

Register of Deeds Stamp & File Number

4. Lot No. _____, Recorded Plat _____
5. Private Claims _____

I, Randal D. Feenstra, in a field survey on Sept 18, 1996 do hereby state that under requirements of P.A. 74, Michigan P.A. of 1970, the corner points mentioned in lines 1 and 2 above were in conformance with regulations and rules therefore as required in the current manual of survey instructions of the United States Department of the Interior, Bureau of Land Management or by a decree of a Court of Law and/or that the corner points mentioned in lines 3, 4 and 5 above were in conformance with the rules of the Michigan Board of Land Surveyors or by a Decree of a Court of Law, established, re-established, monumented, recovered, found as expressed below:

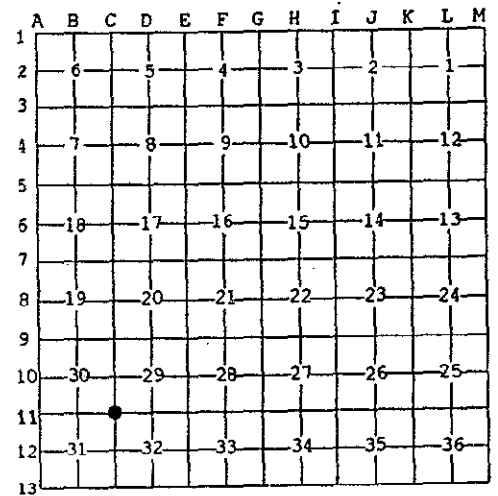

NOTE: Not more than 2 corners, all in the same town and range, may be recorded on this certificate.


A. Description of original monument and accessories and/or subsequent restoration:

G.L.O. Post	L-3, P-43, Solid Bar	L-3, P-76, Rebar	L-5, P-189
Lucius Lyons, (1832)	PK in side T. Pole SW 46.86'	USGS Marker N45°W 39.22'	Cast Iron Monument
10" Beech S65°E 11 lks	PK in side T. Pole SE 54.43'	T. Pole N45°W 46.05'	T. Pole SE 54.50'
7" Cherry N49°W 18 lks	PK in side T. Pole NNW 46.05'	T. Pole S45°W 46.88'	USGS Marker SE 36.25'
		T. Pole S50°E 54.59'	T. Pole SW 46.71'
		Hwy. Marker S40°E 36.16'	T. Pole NW 46.06'

B. Description of corner evidence found and/or method applied in restoring or reestablishing corner:
C-11 Found: Broken Cast Iron Monument in Monument Box in Pavement

PK in SW side P. Pole	Az. 126°	54.52'
PK in NW side P. Pole	Az. 230°	46.64'
PK in NE side P. Pole	Az. 316°	46.41'
Conc. Hwy Marker	Az. 143°	36.15' ±

Accepted as a careful and faithful perpetuation of the position of the original corner

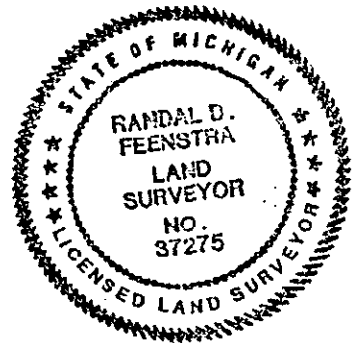

C. Description of monument for corner and accessories established to perpetuate locating the position of the corner:

C-11 Cast Iron Monument in Box
 Set Nail and Ottawa County Remon Tag in SW side P. Pole Az. 126° 54.52'
 Set Nail and Ottawa County Remon Tag in W side 20" Maple Az. 173° 100.81'
 Set Nail and Ottawa County Remon Tag in NW side P. Pole Az. 230° 46.64'
 Set Nail and Ottawa County Remon Tag in NE side P. Pole Az. 316° 46.41'
 Centerline E/W Bit. road 0.5' S. (Adams St.)
 On Centerline Bit. road to N (40th Ave.); Centerline gravel road to S 5' W (40th Ave.)

P.A. 345 OTTAWA COUNTY
PEER APPROVED 10-21-96

YDN

Signed by Randal D. Feenstra
Surveyor's Michigan License No. 37275

Date October 10, 1996