

SURVEY & REMONUMENTATION

APR 24 1995

COMMISSION

OTTAWA COUNTY REMONUMENTATION
LAND CORNER RECORDATION CERTIFICATE
 Filing Requirement of Act 74, Mich. P.A. 1970

RECORDED

94 DEC 15 AM 11:51

D. J. Kellman
 REGISTER OF DEEDS
 OTTAWA COUNTY, MI


For corners in

<u>Ottawa</u> (County)	Located In:	Corner Code #
	Jamestown Township	
1. Public Land Survey	T 5N R 13W	D-3
	T _____ R _____	_____
	T _____ R _____	_____
	T _____ R _____	_____
2. Property Controlling in Section	S _____ T _____ R _____	_____
	S _____ T _____ R _____	_____
3. Miscellaneous Property in Sec.	S _____ T _____ R _____	_____
	S _____ T _____ R _____	_____
4. Lot No. _____, Recorded Plat _____		
5. Private Claims _____		

Register of Deeds Stamp & File Number

I, Rodney D. Unema, in a field survey on Dec. 8, 19 94, do hereby certify that under requirements of P.A. 74, Michigan P.A. of 1970, the corner points mentioned in lines 1 and 2 above were in conformance with regulations and rules therefore as required in the current manual of survey instructions of the United States Department of the Interior, Bureau of Land Management or by a decree of a Court of Law and/or that the corner points mentioned in lines 3, 4 and 5 above were in conformance with the rules of the Michigan Board of Land Surveyors or by a Decree of a Court of Law; established, re-established, monumented, re-monumented, recovered, found as expressed below:

NOTE: Not more than 4 corners, all in the same town and range, may be recorded on this certificate.

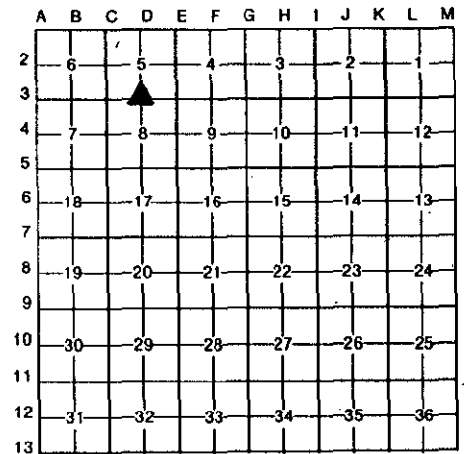

CONTINUED OVER--

A. Description of original monument and accessories and/or subsequent restoration:

D-3 1/4 Corner Between Sections 5 and 8	L.C.R.C. Liber 2, Pg. 293	L.C.R.C. Liber 2, Pg. 557
Original gov't corner set in Dec. 1831 by Sylvester Sibley	Aug. 28, 1973	Sept. 9, 1974
Set 1/4 post	Found 3/4" iron	Found 1" round iron
Sugar 12" N44°W 31 links	Brush line to South	SE cor house #3625 NNW 100.46'
W. Ash 40" S80°E 16 links	SE cor garage NNW 100.50'	PK in N sde T.Pole WSW 129.19'
	Iron to N 33.02'	"X" in W end conc. culv. ESE 29.35'
		Spike in W sde 4" Wild Cherry North 34.87'

B. Description of corner evidence found and/or method applied in restoring or reestablishing corner:

D-3 Found capped iron in Mon. Box on C/L B.T. of Quincy St.	N30°W 100.42'
SE garage cor. brick house #3625	N43°E 118.51'
SW house cor. brick house #3575	N00°E 34.87'
M. to C/L 10" Wild Cherry (didn't find spike)	N54°E 145.79'

Accepted as a careful perpetuation of the position of the original corner, and replaced capped iron with a Std. O.C. Cap on 3/4" x 24" iron bar in Mon. Box.

P.A. 345 OTTAWA COUNTY
 PEER APPROVED *[Signature]* 12/12/94

C. Description of monument for corner and accessories established to perpetuate location of the corner:

D-3 1/4 Corner between Sections 5 and 8	S20°W 89.98'
Std. O.C. Cap on 3/4" OD iron bar in Mon. Box	N08°E 26.20'
Set nail & O.C. tag in E sde of 8" Fruit Tree	N30°W 100.42'
Set nail & O.C. tag in W sde of P.Pole	N43°E 118.51'
SE garage cor. brick house #3625	N54°W 145.79'
SW house cor. brick house #3575	
SW house cor. brick house #3625	
On C/L E-W B.T. road (Quincy St.)	



Signed by *Rodney D. Unema* Date DEC. 12, 1994
 Surveyor's Michigan License No. 33987

L.C.R.C. Liber 2, Pg. 577

Sept. 20, 1974

Found 3/4" iron pipe

SE cor house NW 100.49'

SW cor house NW 145.78'

T.Pole WSW 128.88'

Capped iron #8618 North 33.00'

2733
3000
3000
3000