

**SURVEY &  
REMONUMENTATION**

APR 05 1996

OTTAWA COUNTY REMONUMENTATION  
**LAND CORNER RECORDATION CERTIFICATE**  
Filing Requirement of Act 74, Mich. P.A. 1970

**COMMISSION**

For corners in

OTTAWA

(County)

Located In:  
Jamestown Township

Corner Code #

- |                                    |   |    |   |     |     |
|------------------------------------|---|----|---|-----|-----|
| 1. Public Land Survey              | T | 5N | R | 13W | D-5 |
|                                    | T |    | R |     |     |
|                                    | T |    | R |     |     |
|                                    | T |    | R |     |     |
| 2. Property Controlling in Section | S |    | T | R   |     |
|                                    | S |    | T | R   |     |
| 3. Miscellaneous Property in Sec.  | S |    | T | R   |     |
|                                    | S |    | T | R   |     |

**RECORDED**

95 NOV 15 PM 2:11

*Phyllis S. Callman*  
REGISTER OF DEEDS  
OTTAWA COUNTY, MI

Register of Deeds Stamp & File Number

4. Lot No. \_\_\_\_\_, Recorded Plat \_\_\_\_\_  
5. Private Claims \_\_\_\_\_

A	B	C	D	E	F	G	H	I	J	K	L	M
2	6	5	4	3	2	1						
3												
4	7	8	9	10	11	12						
5												
6	18	17	16	15	14	13						
7												
8	19	20	21	22	23	24						
9												
10	30	29	28	27	26	25						
11												
12	31	32	33	34	35	36						
13												

I, Rodney D. Unema, in a field survey on October 12, 19 95, do hereby certify that under requirements of P.A. 74, Michigan P.A. of 1970, the corner points mentioned in lines 1 and 2 above were in conformance with regulations and rules therefore as required in the current manual of survey instructions of the United States Department of the Interior, Bureau of Land Management or by a decree of a Court of Law and/or that the corner points mentioned in lines 3, 4 and 5 above were in conformance with the rules of the Michigan Board of Land Surveyors or by a Decree of a Court of Law; established, re-established, monumented, re-monumented, recovered, found as expressed below:

**NOTE: Not more than 4 corners, all in the same town and range, may be recorded on this certificate.**

**A. Description of original monument and accessories and/or subsequent restoration:**

D-5 1/4 corner between Sections 8 and 17	Dec. 1831, original govt corner set by S. Sibley	LCRC Lib. 2, Pg 293 (8/73)	Found Bt spike	LCRC Lib. 2, Pg 577 (9/74)	LCRC Lib 2, Pg 771 (5/7)
Set Post	Nail sde TP	NNE 30.03'	Found Bt Spike	TP	WNW 102.54'
12" Sugar N42°W 21 links	Nail sde PP	S23.13'	18" Maple	N43.58'	PP South 22.79'
7" Beech S32°E 29 links	φ blktop	N 4.0'	PP	NW 102.54'	TP NNE 29.71'
	Nail sde TP	WNW 103.20'	PP	NE 29.71'	18" Maple N 43.58'

**B. Description of corner evidence found and/or method applied in restoring or reestablishing corner:**

D-5 Found 4" C.I.M. in Mon. Box; φ of Riley is North 4.0'  
Found nail & BC in E sde P. Pole S03°W 23.13'  
Found nail in W sde 30" Butternut N05°E 44.33'  
On tree row to North and South  
No other witnesses remaining.

Accepted as a careful perpetuation of the position of the original corner.


P.A. 345 OTTAWA COUNTY

PEER APPROVED 10/23/95

*Rodney D. Unema*

**C. Description of monument for corner and accessories established to perpetuate locating the position of the corner:**

D-5 1/4 corner between Sections 8 and 17  
4" diameter cast iron monument in monument box  
φ of Riley Street pavement North 4.0'  
Set nail & OC tag in E sde P. Pole S03°W 23.10'  
Set nail & OC tag in W sde 30" Butternut N05°E 44.36'  
SE corner of hse # 3650 S47°W 224.22'  
Set nail & OC tag in S end of 18" CMP S78°E 142.67'  
Tree row to North and South

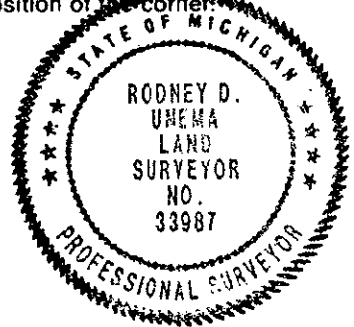

Signed by Rodney D. Unema Date October 20, 1995

Surveyor's Michigan License No. 33987