

**SURVEY & REMONUMENTATION**

APR 05 1996

**COMMISSION**

For corners in

OTTAWA  
(County)

OTTAWA COUNTY REMONUMENTATION

**LAND CORNER RECORDATION CERTIFICATE**

Filing Requirement of Act 74, Mich. P.A. 1970

**RECORDED**

95 NOV 15 PM 2:11


REGISTER OF DEEDS  
OTTAWA COUNTY, MI

Register of Deeds Stamp & File Number

|                                       |                          |               |
|---------------------------------------|--------------------------|---------------|
|                                       | Located In:              | Corner Code # |
|                                       | Jamestown Township       |               |
| 1. Public Land Survey                 | T <u>5N</u> R <u>13W</u> | <u>D-7</u>    |
|                                       | T _____ R _____          | _____         |
|                                       | T _____ R _____          | _____         |
|                                       | T _____ R _____          | _____         |
| 2. Property Controlling in Section    | S _____ T _____ R _____  | _____         |
|                                       | S _____ T _____ R _____  | _____         |
| 3. Miscellaneous Property in Sec.     | S _____ T _____ R _____  | _____         |
|                                       | S _____ T _____ R _____  | _____         |
| 4. Lot No. _____, Recorded Plat _____ |                          |               |
| 5. Private Claims _____               |                          |               |

I, Rodney D. Unema, in a field survey on October 12, 19 95, do hereby certify that under requirements of P.A. 74, Michigan P.A. of 1970, the corner points mentioned in lines 1 and 2 above were in conformance with regulations and rules therefore as required in the current manual of survey instructions of the United States Department of the Interior, Bureau of Land Management or by a decree of a Court of Law and/or that the corner points mentioned in lines 3, 4 and 5 above were in conformance with the rules of the Michigan Board of Land Surveyors or by a Decree of a Court of Law; established, re-established, monumented, re-monumented, recovered, found as expressed below:

**NOTE: Not more than 4 corners, all in the same town and range, may be recorded on this certificate.**

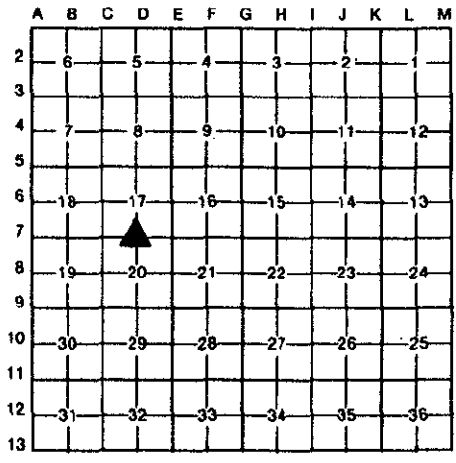

A. Description of original monument and accessories and/or subsequent restoration:  
 D-7 1/4 corner common to Sections 17 and 20  
 Dec., 1831, Original Corner set LCRC Liber 1, Page 67 (Sept, 1971)  
 by Sylvester Sibley Iron in Mon. Box  
 Set 1/4 Section post Fence post S 33'  
 8" Beech N35°E 10 links φ E end culvert N 25'  
 6" Beech S62°W 3 links φ W end culvert NW 33'

LCRC Liber 5, Page 187 (Dec, 1984)  
 Set Cast Iron Mon.  
 8" Twin Cherry N 51.74'  
 6" Ash S 35.02'

B. Description of corner evidence found and/or method applied in restoring or reestablishing corner:

D-7 - Found Cast Iron Mon. in Mon. Box (top broken)  
 φ E end culv. N fnd "X" in top N10°W 25.47'  
 φ W end culv. NW fnd "X" in top N45°W 36.53'  
 Found nail in E side of 14" Elm South 35.18'  
 φ 8" Tw. Cherry (stump) North 52.1'

Accepted as a careful perpetuation of the position of the original corner.


P.A. 345 OTTAWA COUNTY

PEER APPROVED 10/23/95

*Rodney D. Unema*  
10/27

C. Description of monument for corner and accessories established to perpetuate locating the position of the corner:

D-7 1/4 corner between Sections 17 and 20  
 Cast Iron Mon. in Mon. Box (top broken)  
 φ of Byron Road North 1.5'  
 Set O.C. nail & tag in E sde 14" Elm South 35.15'  
 "X" in top of 12" conc culv E end N10°W 25.74'  
 "X" in top of 12" conc culv W end N45°W 36.53'  
 Set O.C. nail & tag in φ Byron Road East 50.00'  
 Tree row to North and South

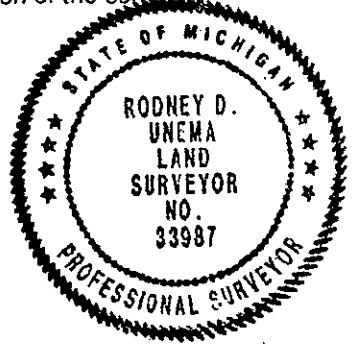

Signed by Rodney D. Unema  
 Surveyor's Michigan License No. 33987

Date October 20, 1995