RECORDED

97 JUL 24 PM 2:24

REGISTER OF DEEDS
OTTAWA COUNTY, MI

Ottawa County Remonumentation
LAND CORNER RECORDATION CERTIFICATE

Filing Requirement of Act 74, Mich. P.A. 1970

For corners in
Ottawa
(County)

	Located In:	Corner Code #:
1. Public Land Survey	T 5N R 13W	D-13 (S½, 32)
	T ___ R ___	Jamestown Twp.
	T ___ R ___	
	T ___ R ___	
2. Property Controlling	S ___ T ___ R ___	
in Section	S ___ T ___ R ___	
3. Miscellaneous	S ___ T ___ R ___	
Property in Sec.	S ___ T ___ R ___	

Register of Deeds Stamp & File Number

4. Lot No. _____, Recorded Plat _____
5. Private Claims _____

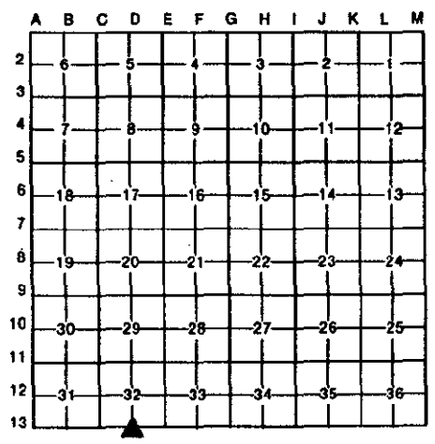

I, John C. Bueche, in a field survey on April 15, 19 97, do hereby certify that under requirements of P.A. 74, Michigan P.A. of 1970, the corner points mentioned in lines 1 and 2 above were in conformance with regulations and rules therefore as required in the current manual of survey instructions of the United States Department of the Interior, Bureau of Land Management or by a decree of a Court of Law and/or that the corner points mentioned in lines 3, 4 and 5 above were in conformance with the rules of the Michigan Board of Land Surveyors or by a Decree of a Court of Law; established, re-established, monumented, re-monumented, recovered, found as expressed below:

NOTE: Not more than 4 corners, all in the same town and range, may be recorded on this certificate.

A. Description of original monument and accessories and/or subsequent restoration:

D-13 GLO, 1831
Lucius Lyon, DS
Set H.M.P.
Maple 14 N 34 E 11
Elm 4 N 83 W 44

L891, P151 Allegan Co.
CP Co. Survey Aug., 1976
No cor. set or found
Shows job 38.01' and
distances

B. Description of corner evidence found and/or method applied in restoring or reestablishing corner:

D-13 Found 2" OD pipe @ fence cor.
On Fence North & 1' South of fence East
Meas. West to SW 32 2653.92; CP Co. 2653.04' comp.
Meas. East to SE 32 2655.83; CP Co. 2657.12' comp.

And is accepted as a careful and faithful perpetuation of the position of the original corner.

P.A. 345 OTTAWA COUNTY
PEER APPROVED 4/21/97
G.D.M.

C. Description of monument for corner and accessories established to perpetuate locating the position of the corner:

D-13 Placed Ottawa Co. Mon. (3/4" x 36" Pin with Alum. Cap) in side 2" pipe
Nail & Ottawa Co. Remon. Tag in N side 10" Elm N 15° W 14.55'
Nail & Ottawa Co. Remon. Tag in S side 8" Ash N 80° W 23.78'
Nail & Ottawa Co. Remon. Tag in W side 8" Elm S 40° W 16.69'
Nail & Ottawa Co. Remon. Tag in N side (vert. in root) 50" Maple S 80° E 7.74'
Allegan Co. Mon. (N 1/4 5, 4-13) East 37.28'
On fence North; fence East is North 1'±
Cor. is on N & E edge of woods

STATE OF MICHIGAN
JOHN C. BUECHE
LAND SURVEYOR
No. 13027
REGISTERED LAND SURVEYOR

Signed by John C Bueche
John C. Bueche, P.S.
Surveyor's Michigan License No. 13027

Date 5-29-97

FORM APPROVED BY MICHIGAN STATE BOARD OF LAND SURVEYORS, JAN. 28, 1971
REVISED MAY 14, 1975
REVISED JAN., 1983