

FEB 24 2000

OTTAWA COUNTY REMONUMENTATION

RECORDED

LAND CORNER RECORDATION CERTIFICATE
Filing Requirement of Act 74, Mich. P.A. 1970

99 DEC -2 PM 1:13

For corners in SECTION

OTTAWA

(County)

Located In:

Corner Code #

- 1. Public Land Survey T5N R 13W E-1 NW cor Sec 4,
T R Jamestown Twp.
- 2. Property Controlling S T R
- in Section S T R
- 3. Miscellaneous S T R
- Property in Sec. S T R

[Signature]
REGISTER OF DEEDS
OTTAWA COUNTY, MI

Register of Deeds Stamp & File Number

- 4. Lot No. _____, Recorded Plat _____
- 5. Private Claims _____

I, Randal J. Vugteveen, in a field survey on October 6, 1999 do hereby state that under requirements of P.A. 74, Michigan P.A. of 1970, the corner points mentioned in lines 1 and 2 above were in conformance with regulations and rules therefore as required in the current manual of survey instructions of the United States Department of the Interior, Bureau of Land Management or by a decree of a Court of Law and for that the corner points mentioned in lines 3, 4 and 5 above were in conformance with the rules of the Michigan Board of Land Surveyors or by a Decree of a Court of Law, established, re-established, monumented, recovered, found as expressed below:

A	B	C	D	E	F	G	H	I	J	K	L	M
1												
2	6		5		4		3		2		1	
3												
4	7		8		9		10		11		12	
5												
6	18		17		16		15		14		13	
7												
8	19		20		21		22		23		24	
9												
10	30		29		28		27		26		25	
11												
12	31		32		33		34		35		36	
13												

NOTE: Not more than 2 corners, all in the same town and range, may be recorded on this certificate.

A. Description of original monument and accessories and/or subsequent restoration:

E-1 GLO August 1831
Lucious Lyon
North Boundary at Post
(Common Corner)

E-1 LCRC Recorded
March 1981 Nederveld
Found ReRod
MSHD Tag on P. Pole SE 36.41'
Centerline hydrant NW 42.92'
Centerline manhole ENE 23.8'
Centerline manhole N 40.50'

E-1 LCRC Liber 6, Page 36
March 1990 P & N
Found RLS Iron
Centerline New Holland Centerline 32nd
SE 36.43' Nail & Tag SW side P.P.
NE 46.34' PK NW side P.P.
NW 79.31' PK E side 16" Maple
SW 58.56 PK S side P.P.

B. Description of corner evidence found and/or method applied in restoring or reestablishing corner:

E-1 Found 1/2" Rebar 1.5' East of centerline "X"

Center of hydrant N43°W 42.98'
Center of manhole North 40.5'
Center of manhole N50°E 24.0'
Center of 18" Maple N52°W 79.3'


Accepted 1/2" Rebar as a careful and faithful
perpetuation of the position of the original corner

Removed 1/2" Rebar and replaced with a 3/4" X 24"
solid bar with Remon Cap in Monument Box

C. Description of monument for corner and accessories established to perpetuate locating the position of the corner:

E-1 3/4" X 24" solid bar with Remon Cap in Monument Box

Set Nail & Remon Tag in N'y side P.Pole S50°E 47.48'
Set Nail & Remon Tag in SE side P. Pole N42°E 46.22'
Set Nail & Remon Tag in SW side Signal Pole N49°W 47.86'
Set Nail & Remon Tag in N side P. Pole S57°W 57.49'
On centerline E&W road
1.5' East of N&S road
Corner is common to E-13 Georgetown Township

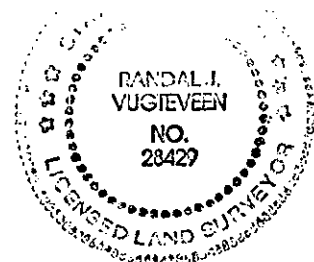

\$11.00 CORNER
Receipt #64945

Signed by [Signature]
Surveyor's Michigan License No. 28429

Date OCTOBER 27, 1999

FEB 24 2000

SECTION

Section 32, Georgetown Twp.

