

1993

OTTAWA COUNTY REMONUMENTATION
LAND CORNER RECORDATION CERTIFICATE
Filing Requirement of Act 74, Mich. P.A. 1970

RECORDED

93 DEC 15 AM 9:30

COMMISSION

Reginald Kullman
REGISTER OF DEEDS
OTTAWA COUNTY, MI

For corners in

Ottawa
(County)

Located In:


Corner Code #

Jamestown Township

1. Public Land Survey	T	5N	R	13W	E-3
	T		R		
	T		R		
	T		R		
2. Property Controlling in Section	S		T	R	
	S		T	R	
3. Miscellaneous Property in Sec.	S		T	R	
	S		T	R	

Register of Deeds Stamp & File Number

4. Lot No. _____, Recorded Plat _____
5. Private Claims _____

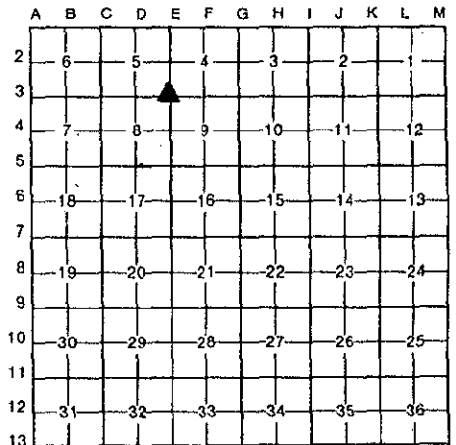

I, Rodney D. Unema, in a field survey on December 4, 19 93, do hereby certify that under requirements of P.A. 74, Michigan P.A. of 1970, the corner points mentioned in lines 1 and 2 above were in conformance with regulations and rules therefore as required in the current manual of survey instructions of the United States Department of the Interior, Bureau of Land Management or by a decree of a Court of Law and/or that the corner points mentioned in lines 3, 4 and 5 above were in conformance with the rules of the Michigan Board of Land Surveyors or by a Decree of a Court of Law; established, re-established, monumented, re-monumented, recovered, found as expressed below:

NOTE: Not more than 4 corners, all in the same town and range, may be recorded on this certificate.

A. Description of original monument and accessories and/or subsequent restoration:

E-3 Corner Common to Sections 4, 5, 8 and 9

L.C.R.C., Liber 6, Page 37 (3-90)

L.C.R.C., Liber 2, Page 557 (Sept. 74)

L.C.R.C., Liber 2, Page 293 (Aug. 73)

1" iron in Mon. Box		1/2" iron rod	NNE	144.38'	1/2" steel rod	NW	60.62'	
PK SW sde PP	NW	59.33'	Spk in W sde 14" Maple	NNW	143.47'	Nail sde PP	SE	41.5'
PK top of cor fe post	NE	59.81'	SE cor brick planter	NW	74.59'	C/L st. sign	SW	102.20'
E edge of gas marker	SE	51.01'	PK in NE sde fe post of pool fence	WNW	94.76'	NE cor hse fndn		
PK E sde 4" Maple	SW	80.92'	PK in SW sde fe post of pool fence	SW	108.67'			
			NE cor bottom step hse #4071					

B. Description of corner evidence found and/or method applied in restoring or reestablishing corner:

E-3 Found 1" solid iron in Mon. Box at intersection of Quincy St. and 32nd Ave.

Found PK SW sde P.Pole	N50°W	59.33'
Found E edge gas marker	S30°E	51.0'
Found C/L 12" Maple	S50°W	81.0'


Accepted position of 1" iron as a careful perpetuation of the position of the original corner; and replaced with Std. O.C. Cap on 3/4" x 24" iron bar in Mon. Box.

C. Description of monument for corner and accessories established to perpetuate locating the position of the corner:

E-3 Corner Common to Sections 4, 5, 8 and 9

Std. O.C. Cap on 3/4" x 24" iron bar in Mon. Box at intersection of Quincy St. and 32nd Ave.

Nail & O.C. tag in E'ly sde of P.Pole	N40°E	58.48'
Nail & O.C. tag in SW sde of P.Pole	N50°W	59.29'
Nail & O.C. tag in NW sde of 12" Maple	S50°W	80.71'
Nail & O.C. tag in N'ly sde of 12" Elm	S45°E	125.40'

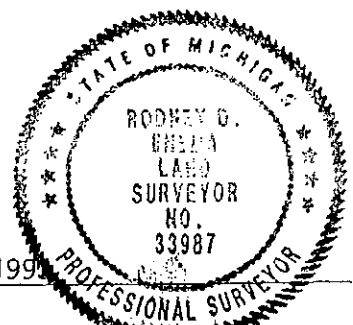

Signed by Rodney D. Unema
Surveyor's Michigan License No. 33987

Date December 6, 1993