

SUPPLEMENTAL
REMONUMENTATION

1993

COMMISSION

OTTAWA COUNTY REMONUMENTATION
LAND CORNER RECORDATION CERTIFICATE
Filing Requirement of Act 74, Mich. P.A. 1970

RECORDED

93 DEC 15 AM 9:30


Rodney D. Unema
REGISTER OF DEEDS
OTTAWA COUNTY, MI

For corners in

<u>Ottawa</u> (County)	Located In:	Corner Code #
	Jamestown Township	E-4
1. Public Land Survey	T 5N R 13W	_____
	T _____ R _____	_____
	T _____ R _____	_____
	T _____ R _____	_____
2. Property Controlling in Section	S _____ T _____ R _____	_____
	S _____ T _____ R _____	_____
3. Miscellaneous Property in Sec.	S _____ T _____ R _____	_____
	S _____ T _____ R _____	_____
4. Lot No. _____, Recorded Plat _____		
5. Private Claims _____		

Register of Deeds Stamp & File Number

I, Rodney D. Unema, in a field survey on December 4, 19 93, do hereby certify that under requirements of P.A. 74, Michigan P.A. of 1970, the corner points mentioned in lines 1 and 2 above were in conformance with regulations and rules therefore as required in the current manual of survey instructions of the United States Department of the Interior, Bureau of Land Management or by a decree of a Court of Law and/or that the corner points mentioned in lines 3, 4 and 5 above were in conformance with the rules of the Michigan Board of Land Surveyors or by a Decree of a Court of Law; established, re-established, monumented, re-monumented, recovered, found as expressed below:

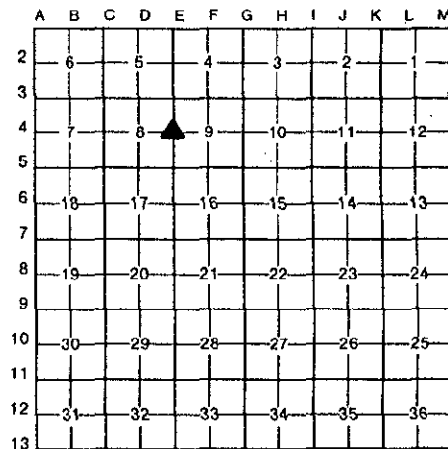

NOTE: Not more than 4 corners, all in the same town and range, may be recorded on this certificate.

A. Description of original monument and accessories and/or subsequent restoration:

E-4 1/4 corner between Sections 8 and 9

L.C.R.C., Liber 2, Page 577 (Sept. 74)
RR spike
PP NW 51.60'
PP SW 74.15'
PP SE 64.67'

L.C.R.C., Liber 2, Page 293 (Aug. 73)
RR spike
MSHD tag in sd PP NW 51.59'
MSHD tag in sde PP SW 74.13'
Nail in sde PP SSE 64.68'

B. Description of corner evidence found and/or method applied in restoring or reestablishing corner:

E-4 Found angle iron in Mon. Box at intersection of Greenly St. and 32nd Ave.

Found nail & M.S.H.D. tag in NE sde of P.Pole	N72°W	51.64'
Found nail & M.S.H.D. tag in	S41°W	74.15'
Found PK nail in SW sde of P.Pole	S30°E	67.64'
Found PK nail in NW sde of P.Pole	N60°E	41.37'

Accepted angle iron as a careful perpetuation of the position of the original corner and set Std. O.C. Cap on 3/4" x 24" iron bar in place of angle iron.

C. Description of monument for corner and accessories established to perpetuate locating the position of the corner:


E-4 1/4 corner between Sections 8 and 9

Std. O.C. Cap on 3/4" x 24" iron bar in Mon. Box at intersection of 32nd Ave. and Greenly St.

Nail & O.C. tag in NE sde of P.Pole	N72°E	51.81'
Nail & O.C. tag in SW sde of P.Pole	S30°E	67.70'
Nail & O.C. tag in SE sde of P.Pole	S41°W	74.33'
Nail & O.C. tag in NW sde of 20" Maple	N50°E	57.92'

Signed by Rodney D. Unema
Surveyor's Michigan License No. 33987

Date December 6, 1993

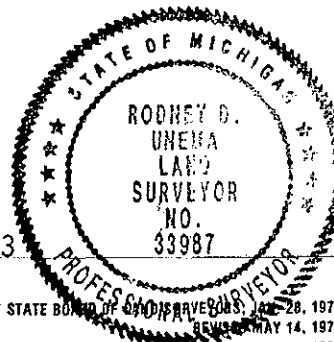

FORM APPROVED BY MICHIGAN STATE BOARD OF LAND SURVEYORS, 1971
REVISED MAY 14, 1975
REVISED JAN., 1993