

SURVEY & REMONUMENTATION

OCT 24 1994

COMMISSION

OTTAWA COUNTY REMONUMENTATION
LAND CORNER RECORDATION CERTIFICATE
 Filing Requirement of Act 74, Mich. P.A. 1970

RECORDED

94 OCT -7 PM 12:33

For corners in

| | | |
|------------------------------------------|--------------------------|---------------|
| <u>Ottawa</u> <small>(County)</small> | Located In: | Corner Code # |
| | Jamestown Township | |
| 1. Public Land Survey | T <u>5N</u> R <u>13W</u> | <u>E-6</u> |
| | T _____ R _____ | _____ |
| | T _____ R _____ | _____ |
| | T _____ R _____ | _____ |
| 2. Property Controlling in Section | S _____ T _____ R _____ | _____ |
| | S _____ T _____ R _____ | _____ |
| 3. Miscellaneous Property in Sec. | S _____ T _____ R _____ | _____ |
| | S _____ T _____ R _____ | _____ |

Polycarpus Redman
 REGISTER OF DEEDS
 OTTAWA COUNTY, MI.

Register of Deeds Stamp & File Number

4. Lot No. _____, Recorded Plat _____
 5. Private Claims _____

| | | | | | | | | | | | | | |
|----|----|----|----|----|----|----|----|---|---|---|---|---|---|
| | A | B | C | D | E | F | G | H | I | J | K | L | M |
| 2 | 6 | 5 | 4 | 3 | 2 | 1 | | | | | | | |
| 3 | | | | | | | | | | | | | |
| 4 | 7 | 8 | 9 | 10 | 11 | 12 | | | | | | | |
| 5 | | | | | | | | | | | | | |
| 6 | 18 | 17 | ▲ | 16 | 15 | 14 | 13 | | | | | | |
| 7 | | | | | | | | | | | | | |
| 8 | 19 | 20 | 21 | 22 | 23 | 24 | | | | | | | |
| 9 | | | | | | | | | | | | | |
| 10 | 30 | 29 | 28 | 27 | 26 | 25 | | | | | | | |
| 11 | | | | | | | | | | | | | |
| 12 | 31 | 32 | 33 | 34 | 35 | 36 | | | | | | | |

I, Rodney D. Unema, in a field survey on September 17, 19 94, do hereby certify that under requirements of P.A. 74, Michigan P.A. of 1970, the corner points mentioned in lines 1 and 2 above were in conformance with regulations and rules therefore as required in the current manual of survey instructions of the United States Department of the Interior, Bureau of Land Management or by a decree of a Court of Law and/or that the corner points mentioned in lines 3, 4 and 5 above were in conformance with the rules of the Michigan Board of Land Surveyors or by a Decree of a Court of Law; established, re-established, monumented, re-monumented, recovered, found as expressed below:

NOTE: Not more than 4 corners, all in the same town and range, may be recorded on this certificate.

A. Description of original monument and accessories and/or subsequent restoration:

E-6 1/4 Corner Common to Sections 16 and 17

| | |
|---|---|
| Original gov't corner set in Dec. 1831 by Sylvester Sibley Set H.W.P. Sugar 14" S53°E 19 links Sugar 12" S16°W 14 links | L.C.R.C. Liber 2, Page 773 (May 1975) Cast iron monument P.Pole SW 53.75' Trans Pole W 124.94' Guy Pole NNE 91.28' P.Pole NW 68.02' St. Sign E 19.57' |
|---|---|

B. Description of corner evidence found and/or method applied in restoring or reestablishing corner:


E-6
 Found 4" dia. cast iron mon. in mon. box (4" below top of box)
 Mon. is 3' East of C/L 32nd Avenue (N-S BT road)
 Found nail & tag in E'ly side P.Pole S68°W 53.79'
 Found nail & tag in SE side P.Pole N47°W 67.92'
 Found nail & tag in S side Guy Pole N16°E 91.22'
 Street sign N88°E 19.63'
 * Accepted as a careful perpetuation of the position of the original corner.

RA. 345 OTTAWA COUNTY

PEER APPROVED 9/19/94
Rodney D. Unema

C. Description of monument for corner and accessories established to perpetuate locating the position of the corner:

| | |
|---|--------------------------------------------------------------|
| E-6 1/4 Corner Common to Sections 16 and 17 4" dia. conc. mon. in mon. box (4" below top of box) 3' East of C/L 32nd Avenue (N-S BT road) Set nail & O.C. tag in SE side P.Pole Set nail & O.C. tag in S side P.Pole Set nail & O.C. tag in SE side GUY Pole Set nail & O.C. tag in W'ly side 36" Maple | S68°W 54.19' N47°W 68.50' N16°E 91.52' S25°E 94.02' |
|---|--------------------------------------------------------------|

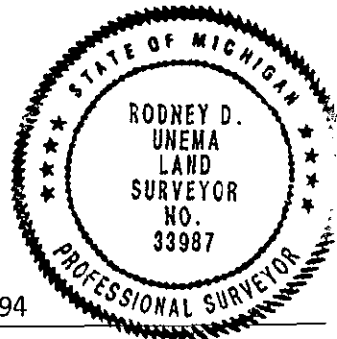

Signed by Rodney D. Unema
 Surveyor's Michigan License No. 33987

Date September 19, 1994