

OCT 24 1994

COMMISSION

OTTAWA COUNTY REMONUMENTATION
LAND CORNER RECORDATION CERTIFICATE
 Filing Requirement of Act 74, Mich. P.A. 1970

RECORDED

94 OCT -7 PM 12:33


For corners in

<u>Ottawa</u> <small>(County)</small>	Located In:	Corner Code #
	Jamestown Township	
1. Public Land Survey	T <u>5N</u> R <u>13W</u>	<u>E-7</u>
	T _____ R _____	_____
	T _____ R _____	_____
	T _____ R _____	_____
2. Property Controlling in Section	S _____ T _____ R _____	_____
	S _____ T _____ R _____	_____
3. Miscellaneous Property in Sec.	S _____ T _____ R _____	_____
	S _____ T _____ R _____	_____
4. Lot No. _____, Recorded Plat _____		
5. Private Claims _____		

Phyllis Redman
 REGISTER OF DEEDS
 OTTAWA COUNTY, MI

Register of Deeds Stamp & File Number

I, Rodney D. Unema, in a field survey on September 17, 19 94, do hereby certify that under requirements of P.A. 74, Michigan P.A. of 1970, the corner points mentioned in lines 1 and 2 above were in conformance with regulations and rules therefore as required in the current manual of survey instructions of the United States Department of the Interior, Bureau of Land Management or by a decree of a Court of Law and/or that the corner points mentioned in lines 3, 4 and 5 above were in conformance with the rules of the Michigan Board of Land Surveyors or by a Decree of a Court of Law; established, re-established, monumented, re-monumented, recovered, found as expressed below:

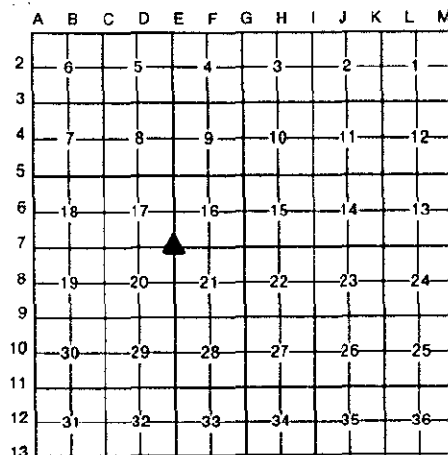

NOTE: Not more than 4 corners, all in the same town and range, may be recorded on this certificate.

A. Description of original monument and accessories and/or subsequent restoration:

E-7 Corner Common to Sections 16, 17, 20 and 21

Original gov't corner set in Dec. 1831

by Sylvester Sibley
 Set H.W.P.

Beech 10" S43°W 31 links
 Beech 8" S75°E 14 links

L.C.R.C. Liber 2, Page 657
 (Oct. 1974)
 Spike in Mon Box
 NE 16" Hickory 118.25'
 SE 43.2 St. Sign
 SW 69.05 P.P.

L.C.R.C. Liber 5, Page 187
 (Dec. 1984)
 Cast Iron Monument
 20" Hickory NE 119.24'
 Cable Marker NW 50.48'
 Power Pole SW 69.60'
 St. Sign SE 43.20'

B. Description of corner evidence found and/or method applied in restoring or reestablishing corner:

E-7
 Found 3" dia. cast iron mon. in mon. box (6" below top of box)
 at C/L "X" of Byron Road & 32nd Avenue.

No remaining witnesses found.

* Accepted as a careful perpetuation of the position of the original corner.

P.A. 345 OTTAWA COUNTY


PEER APPROVED 9/19/94

Rodney D. Unema

C. Description of monument for corner and accessories established to perpetuate locating the position of the corner:

E-7 Corner Common to Sections 16, 17, 20 and 21.
 3" dia. cast iron mon. in mon. box (6" below top of box)
 at C/L "X" of Byron Road & 32nd Avenue
 Set nail & O.C. tag in curb joint
 Set nail & O.C. tag in curb joint
 Set nail & O.C. tag in NE side Guy Pole
 Set nail & O.C. tag in SE side P.Pole

N41°E 43.62'
 N35°W 45.73'
 S39°E 46.31'
 S47°W 68.77'

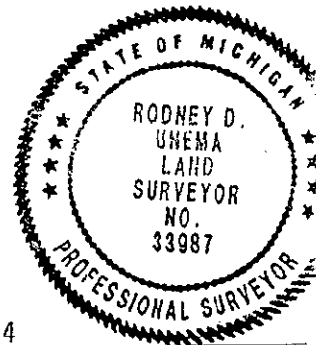

Signed by Rodney D. Unema

Date September 19, 1994

Surveyor's Michigan License No. 33987