

**SURVEY &  
REMONUMENTATION**

APR 05 1996

**COMMISSION**

OTTAWA COUNTY REMONUMENTATION  
**LAND CORNER RECORDATION CERTIFICATE**  
Filing Requirement of Act 74, Mich. P.A. 1970

For corners in

<u>OTTAWA</u> (County)	Located In: <u>Jamestown Township</u>	Corner Code <u>##</u> <u>E-8</u>
1. Public Land Survey	T <u>5N</u> , R <u>13W</u>	<u>_____</u>
	T <u>_____</u> R <u>_____</u>	<u>_____</u>
	T <u>_____</u> R <u>_____</u>	<u>_____</u>
	T <u>_____</u> R <u>_____</u>	<u>_____</u>
2. Property Controlling in Section	S <u>_____</u> T <u>_____</u> R <u>_____</u>	<u>_____</u>
	S <u>_____</u> T <u>_____</u> R <u>_____</u>	<u>_____</u>
3. Miscellaneous Property in Sec.	S <u>_____</u> T <u>_____</u> R <u>_____</u>	<u>_____</u>
	S <u>_____</u> T <u>_____</u> R <u>_____</u>	<u>_____</u>
4. Lot No. _____, Recorded Plat _____		
5. Private Claims _____		

**RECORDED**

95 NOV 15 PM 2: 11

*Phyllis R. Anderson*  
REGISTER OF DEEDS  
OTTAWA COUNTY, MI

Register of Deeds Stamp & File Number

I, Rodney D. Unema, in a field survey on October 12, 19 95, do hereby certify that under requirements of P.A. 74, Michigan P.A. of 1970, the corner points mentioned in lines 1 and 2 above were in conformance with regulations and rules therefore as required in the current manual of survey instructions of the United States Department of the Interior, Bureau of Land Management or by a decree of a Court of Law and/or that the corner points mentioned in lines 3, 4 and 5 above were in conformance with the rules of the Michigan Board of Land Surveyors or by a Decree of a Court of Law, established, re-established, monumented, re-monumented, recovered, found as expressed below:

**NOTE: Not more than 4 corners, all in the same town and range, may be recorded on this certificate.**

A. Description of original monument and accessories and/or subsequent restoration:  
E-8 1/4 corner between Sections 20 and 21

Dec 1831 original gov't corner set by Sylvester Sibley	LCRC Lib 1, Pg 65 (9/71)	Found iron pipe
Set H.W.P.	Nail in 48" Maple SW 35.83'	
22" Beech S20°E 6 links	Nail in P Pole SW 52.22'	
9" Sugar N48°W 35 links	Nail in 48" Maple NE 42.09'	
	Nail in 42" Maple SE 32.14'	
	Nail in P Pole E 27.82'	
	¢ St. sign ESE 21.00'	

Liber 6 of Surveys, Pg 12 (3/87)  
3/4" iron in Mon. Box  
Nail in S sde P Pole East 28.29'  
Nail in NW sde P. Pole WSW 52.69'  
Spike in SW sde 36" Maple SE 33.38'  
Spike in SW sde 18" Maple NW 68.24'

B. Description of corner evidence found and/or method applied in restoring or reestablishing corner:

E-8 Found 3/4" iron pipe in Mon. Box  
¢ of 32nd (N-S) West 1.2'  
On ¢ of Gordon Street to West  
Found nail & BC in S sde P. Pole S85°E 28.30'  
Found nail & BC in W sde 50" Maple N33°E 43.69'  
Found nail in face of P. Pole S85°E 27.81'  
Face of 44" Maple S42°E 32.0'


**P.A. 345 OTTAWA COUNTY**  
**PEER APPROVED 10/23/95**

*Rodney D. Unema*  
*RDU*

Accepted 3/4" iron as a careful perpetuation of the position of the original corner and replaced with standard Ottawa County Remon cap on 3/4" x 24" iron bar in monument box.

C. Description of monument for corner and accessories established to perpetuate locating the position of the corner:

E-8 1/4 corner between Sections 20 and 21  
Standard OC cap on 3/4" x 24" iron bar in Mon. Box  
¢ N-S blacktop road (32nd) West 1.2'  
Set nail & OC tag in W base of 50" Maple N33°E 42.54'  
Set nail & OC tag in S sde P. Pole S85°E 28.35'  
Set nail & OC tag in SW sde 30" Maple N48°W 68.03'  
Set nail & OC tag in SE sde P. Pole S59°W 58.20'

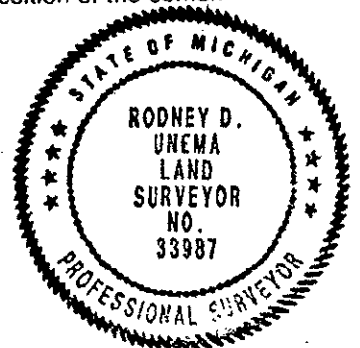

Signed by *Rodney D. Unema*  
Surveyor's Michigan License No. 33987

Date October 20, 1995

FORM APPROVED BY MICHIGAN STATE BOARD OF LAND SURVEYORS, JAN. 28, 1971  
REVISED MAY 14, 1975  
REVISED JAN., 1983