

SURVEY & REMONUMENTATION

APR 25 1995

OTTAWA COUNTY REMONUMENTATION
LAND CORNER RECORDATION CERTIFICATE
Filing Requirement of Act 74, Mich. P.A. 1970

RECORDED
94 DEC -8 PM 12:30

COMMISSION


Sylvester Sibley
REGISTER OF DEEDS
OTTAWA COUNTY, MI

For corners in

Ottawa <small>(County)</small>	Located In: Jamestown Township	Corner Code #
1. Public Land Survey	T <u>5N</u> R <u>13W</u>	<u>E-9</u>
	T _____ R _____	_____
	T _____ R _____	_____
	T _____ R _____	_____
2. Property Controlling in Section	S _____ T _____ R _____	_____
	S _____ T _____ R _____	_____
3. Miscellaneous Property in Sec.	S _____ T _____ R _____	_____
	S _____ T _____ R _____	_____
4. Lot No. _____, Recorded Plat _____		
5. Private Claims _____		

Register of Deeds Stamp & File Number

I, Rodney D. Unema, in a field survey on Nov. 16, 19 94, do hereby certify that under requirements of P.A. 74, Michigan P.A. of 1970, the corner points mentioned in lines 1 and 2 above were in conformance with regulations and rules therefore as required in the current manual of survey instructions of the United States Department of the Interior, Bureau of Land Management or by a decree of a Court of Law and/or that the corner points mentioned in lines 3, 4 and 5 above were in conformance with the rules of the Michigan Board of Land Surveyors or by a Decree of a Court of Law; established, re-established, monumented, re-monumented, recovered, found as expressed below:

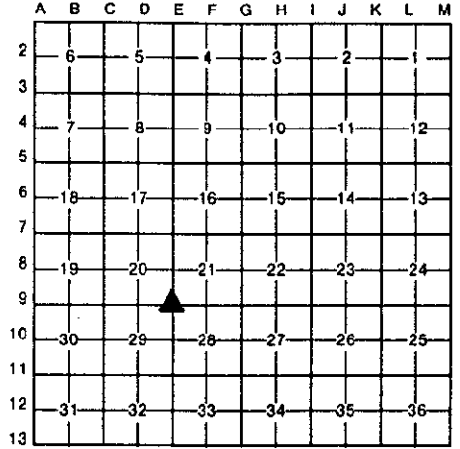

NOTE: Not more than 4 corners, all in the same town and range, may be recorded on this certificate.

A. Description of original monument and accessories and/or subsequent restoration:

E-9 Corner Common to Sections 20, 21, 28 and 29
Original gov't corner set in L.C.R.C. Liber 1, Page 65
Dec. 1831, by Sylvester Sibley (Sept. 22, 1971)
Set post Found steel bar
Beech 14" N48°E 10 links Power pole SW 61.91'
Sugar 6" N85°W 24 links C/L street sign SW 49.57'
18" Maple NW 75.82'
Power pole NW 71.13'
10" Spruce SE 53.05'

Survey recorded in Liber 6,
Page 12 (March 2, 1987)
1/2" iron in Mon. Box
Nail in NW side PP SW 62.75'
Nail in NE side PP NW 74.43'
PK in SW side guy pole SE 30.03'

B. Description of corner evidence found and/or method applied in restoring or reestablishing corner:

E-9
Found 3/4" solid bar in Mon. Box at intersection of 32nd Avenue and Perry St.
Found nail & bottle cap in NW side of P.Pole S56°W 62.75'
Found nail in bottle cap in NE side of P.Pole N47°W 74.46'
Found nail in bottle cap in NE side of 14" Spruce S39°E 53.94'
Center of 24" Maple N63°W 76.56'

Accepted as a careful perpetuation of the position of the original corner, and placed Std. O.C. Cap on existing 3/4" iron bar.

P.A. 345 OTTAWA COUNTY


PEER APPROVED 11/21/94

Rodney D. Unema

C. Description of monument for corner and accessories established to perpetuate locating the position of the corner:

E-9 Corner Common to Sections 20, 21, 28 and 29
Std. O.C. Cap on 3/4" solid iron bar in Mon. Box
Set nail & O.C. tag in NE side of P.Pole
Set nail & O.C. tag in NE side of 14" Spruce
Set nail & O.C. tag in NW side of P.Pole
"+" in conc. headwall (N'ly "+" of 9+12+41 in conc.)
C/L of N-S B.T. road (32nd Avenue)
on C/L of B.T. road (Perry St.) to West and East

N47°W 74.46'
S39°E 53.94'
S56°W 62.75'
N21°E 36.95'
West 5.5'

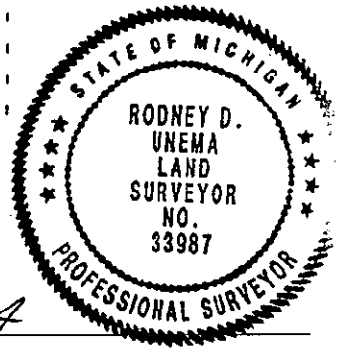

Signed by Rodney D. Unema
Surveyor's Michigan License No. 33987

Date Nov. 18, 1994